


STATE OF KANSAS
STATE CORPORATION COMMISSION

WELL PLUGGING RECORD

Give All Information Completely
Make Required Affidavit
Mail or Deliver Report to:
Conservation Division
State Corporation Commission
800 Bitting Building
Wichita, Kansas

Sedgwick County. Sec. 33 Twp. 26 Rge. 2 (E) (W)
Location as "NE/CNW/SW" or footage from lines SW/4 NW/4 SE/4
Lease Owner John P. Gaty
Lease Name Luening Well No. 1
Office Address 11 Cypress Dr., Wichita, Kansas
Character of Well (completed as Oil, Gas or Dry Hole) Oil
Date well completed June 2, 19 51
Application for plugging filed September 7, 19 54
Application for plugging approved September 7, 19 54
Plugging commenced September 16, 19 54
Plugging completed September 17, 19 54
Reason for abandonment of well or producing formation Production too low to operate.
If a producing well is abandoned, date of last production September 1, 19 54
Was permission obtained from the Conservation Division or its agents before plugging was commenced? yes

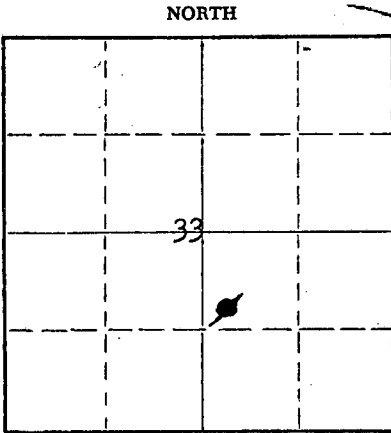

Locate well correctly on above Section Plat

Name of Conservation Agent who supervised plugging of this well Ruel Durkee
Producing formation Simpson Depth to top _____ Bottom _____ Total Depth of Well 3359 Feet
Show depth and thickness of all water, oil and gas formations.

OIL, GAS OR WATER RECORDS

CASING RECORD

FORMATION	CONTENT	FROM	TO	SIZE	PUT IN	PULLED OUT

Describe in detail the manner in which the well was plugged, indicating where the mud fluid was placed and the method or methods used in introducing it into the hole. If cement or other plugs were used, state the character of same and depth placed, from _____ feet to _____ feet for each plug set.

Sand fill from 3359' to 3329
6 sacks cement at 3329
Sand fill from top of cement to 3159'
6 sacks cement at 3159'
Mudded from top of cement to 155'
Set rock bridge with 20 sacks cement at 155'
Mudded to surface with 5 sacks cement for cap.


(If additional description is necessary, use BACK of this sheet)

Name of Plugging Contractor John P. Gaty
Address 11 Cypress Dr., Wichita, Kansas

STATE OF Kansas, COUNTY OF Sedgwick, ss.
Earl Wentworth (employee of owner) or (owner or operator) of the above-described well, being first duly sworn on oath, says: That I have knowledge of the facts, statements, and matters herein contained and the log of the above-described well as filed and that the same are true and correct. So help me God.

(Signature) Earl Wentworth
734 Pippin Court, Wichita, Kansas
(Address)

SUBSCRIBED AND SWORN TO before me this 20th day of September, 19 54
My commission expires December 12, 1955
J. Arnold Dowd
COMMISSION Notary Public.

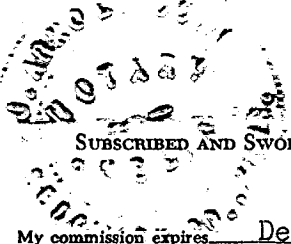

PLUGGING
FILE SEC 33 T 26 R 2E
BOOK PAGE 41 LINE 22

SEP 21 1954
9-21-54
CONSERVATION DIVISION
Wichita, Kansas

WELL LOG - Luening #1

OPERATOR: Mr. J. P. Gaty
c/o Beech Aircraft Corp.
Wichita, Kansas

LOCATION: CSL NW SE
Section 33-26-2E
Sedgwick County, Kansas

CONTRACTOR: Morrison Drilling Company, Inc.
Drawer 712
El Dorado, Kansas

PRODUCTION: _____

Farm: Luening Well No. 1

Date Commenced: May 21, 1951
Date Completed: June 2, 1951

Total Depth: 3360 feet

<u>From</u>	<u>To</u>	<u>Formation</u>
20	65	Cement
65	220	Lime & Shale
220	252	Lime & Shale brks.
252	258	Red Bed
258	285	Lime & Shale brks.
285	310	Lime & Shells
310	316	Red Bed
316	350	Lime & Shale
350	410	Lime
410	500	Shale
500	535	Shale & Lime strks.
535	655	Lime & Shale
655	705	Lime & Shale brks.
705	735	Shale & Shells
735	780	Lime - Hard
780	870	Shale & Lime strks.
870	950	Shale & Shells
950	1270	Shale & Lime
1270	1400	Shale & Shells
1400	1470	Lime & Shale
1470	1505	Shale
1505	1610	Shale & Lime strks.
1610	1635	Shale
1635	1665	Lime & Shale strks.
1665	1835	Shale & Lime
1835	1846	Shale & Shells
1846	1995	Lime w/shale strks.
1995	2125	Shale & Lime strks.
2125	2240	Shale & Lime
2240	2269	Shale & Lime strks.
2269	2334	Lime w/shale strks.
2334	2365	Lime
2365	2440	Shale & Lime strks.
2440	2482	Shale
2482	2550	K. C. Lime
2550	2646	Lime
2646	2710	Shale
2710	2863	Shale & Shells
2863	2945	Shale
2945	3153	Mississippi Lime
3153	3198	Shale & Lime
3198	3244	Shale
3244	3246	Core #1 - Shale
3246	3255	Core #1 - Sand
3255	3282	Shale & Sand
3282	3292	Brown lime
3292	3322	Lime
3322	3360	Shale & Sand
3360		Total Depth.

CABLE TOOL LOG

3360 - 68½ - Cemented sand and green shale
 3368½ - 70½ - Hard cemented sand
 3370½ - Top Arbuckle
 3370½ - 72 - White foss. chert - some stain. Some free oil & 1 BW overnight - plug back and perforated - 3351-55
 1 B. O. per hour - 41 gravity

PLUGGING
 FILE SEC 33 T 26 R 2E
 BOOK PAGE 61 LINE 22

Well Log (Cont.)
Luening #1

I hereby certify that the foregoing is a true and correct copy of the Well Log for the Luening #1 well drilled for Mr. J. P. Gaty and completed June 2, 1951.

MORRISON DRILLING COMPANY, INC.



C. W. Wilson - Secretary-Treasurer

STATE OF KANSAS)
) ss.
COUNTY OF BUTLER)

SUBSCRIBED AND SWORN TO, Before the undersigned, a Notary Public, in and for the County and State aforesaid this 12th day of June, 1951.


Notary Public

My Commission Expires January 10, 1955.