

STATE CORPORATION COMMISSION OF KANSAS
OIL & GAS CONSERVATION DIVISION
WELL COMPLETION OR RECOMPLETION FORM
ACO-1 WELL HISTORY
DESCRIPTION OF WELL AND LEASE

API NO. 15-173-20822-00-00
County Sedgwick
Sec. 27 Twp. 26S Rge. 2 East

Operator: License # 5107
Name H-30 FNC
Address 251 N. WATER
City/State/Zip WICHITA, K.S. 67202

2970 Ft North from Southeast Corner of Section
3300 Ft West from Southeast Corner of Section
(Note: Locate well in section plat below)

Purchaser.....

Lease Name JEFFERIES Well # 4

Operator Contact Person DEAN BRITTING
Phone 316-263-2043

Field Name GREEN WICH

Producing Formation D.G.A.


Contractor: License # 5108
Name M.C. ALISTER DRILLING

Elevation: Ground 1385 KB 1390

Wellsite Geologist JEFF BORK
Phone 316-263-2043

Designate Type of Completion
 New Well Re-Entry Workover
 Oil Gas Dry
 SWD Inj Other (Core, Water Supply etc.)
If OWNO: old well info as follows:
Operator.....
Well Name.....
Comp. Date.....Old Total Depth.....

RECEIVED
STATE CORPORATION COMMISSION
DEC 14 1988
CONSERVATION DIVISION
Wichita, Kansas

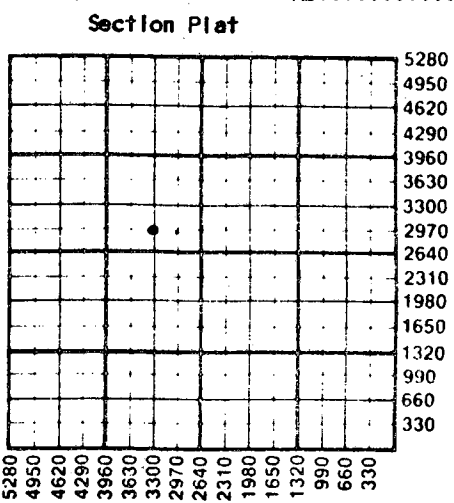

WATER SUPPLY INFORMATION
Disposition of Produced Water: Disposal Repressuring
Docket #

WELL HISTORY
Drilling Method: Mud Rotary Air Rotary Cable
11-17-88 11-25-88 N/A
Spud Date Date Reached TD Completion Date
3335 N/A 11-25-88
Total Depth PBTD
Amount of Surface Pipe Set and Cemented at 209 feet
Multiple Stage Cementing Collar Used? Yes No
If yes, show depth set.....feet
If alternate 2 completion, cement circulated from N/A feet depth to.....w/.....SX cmt
Cement Company Name U.W.I.T.E.D. CEMENTING
Invoice # 1287 11-25-88
AIT I DPA

Questions on this portion of the ACO-1 call:
Water Resources Board (913) 296-3717
Source of Water:
Division of Water Resources Permit # N/A
 Groundwater.....Ft North from Southeast Corner (Well)Ft West from Southeast Corner of Sec Twp Rge East West
 Surface Water.....Ft North from Southeast Corner (Stream, pond etc).....Ft West from Southeast Corner Sec Twp Rge East West
 Other (explain) Wanted from Landowner's
(purchased from city, R.W.D. #)


INSTRUCTIONS: This form shall be completed in triplicate and filed with the Kansas Corporation Commission, 200 Colorado Derby Building, Wichita, Kansas 67202, within 120 days of the spud date of any well. Rule 82-3-130, 82-3-107 and 82-3-106 apply.
Information on side two of this form will be held confidential for a period of 12 months if requested in writing and submitted with the form. See rule 82-3-107 for confidentiality in excess of 12 months.
One copy of all wireline logs and drillers time log shall be attached with this form. Submit CP-4 form with all plugged wells. Submit CP-111 form with all temporarily abandoned wells.

All requirements of the statutes, rules and regulations promulgated to regulate the oil and gas industry have been fully complied with and the statements herein are complete and correct to the best of my knowledge.

Signature Dean Britting
Title V.I.C.E. CHAIRMAN Date 12-13-88

Subscribed and sworn to before me this 13th day of December, 1988.
Notary Public Pamela J. Deitchler
Date Commission Expires June 14, 1990

K.C.C. OFFICE USE ONLY
F Letter of Confidentiality Attached
C Wireline Log Received
C Drillers Timelog Received
Distribution
 KCC SWD/Rep NGPA
 KGS Plug Other
(Specify)
12-14-88
Form ACO-1 (5-86)

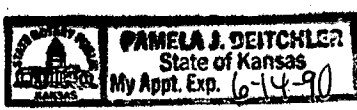

Sec. 201 Wp Charge 27

