

STATE CORPORATION COMMISSION OF KANSAS
OIL & GAS CONSERVATION DIVISION
WELL COMPLETION OR RECOMPLETION FORM
ACO-1 WELL HISTORY
DESCRIPTION OF WELL AND LEASE

Operator: License # 5120
Name Range Oil Company, Inc.
Address 240 Page Court
220 West Douglas
City/State/Zip Wichita, Kansas 67202

Purchaser NONE

Operator Contact Person John Washburn
Phone (316) 265-6231

Contractor: License # 5124
Name Range Drilling Co.

Wellsite-Geologist Bob Olsen
Phone (316) 265-6231

Designate Type of Completion

New Well Re-Entry Workover
 Oil SWD Temp Abd
 Gas Inj Delayed Comp.
 Dry Other (Core, Water Supply etc.)

If OWWO: old well info as follows:

Operator
Well Name
Comp. Date Old Total Depth

WELL HISTORY

Drilling Method:
 Mud Rotary Air Rotary Cable
10-25-85 10-30-85 10-31-85
Spud Date Date Reached TD Completion Date
2765 NONE
Total Depth PBTD

Amount of Surface Pipe Set and Cemented at 218 feet
Multiple Stage Cementing Collar Used? Yes No
If yes, show depth set feet
If alternate 2 completion, cement circulated from feet depth to w/ SX cmt
Cement Company Name
Invoice #

API No. 15-015-22,806-00-00
County Butler
1290' FNL, 2380' FWL, NW
2900' Sec 2 Twp 26S Rge 3 East West

3990-3960 Ft North from Southeast Corner of Section
2900' Ft West from Southeast Corner of Section
(Note: Locate well in section plat below)


Lease Name Foulston Well # 1

Field Name Pauls So.

Producing Formation NONE

Elevation: Ground 1286 KB 1291

Section Plat

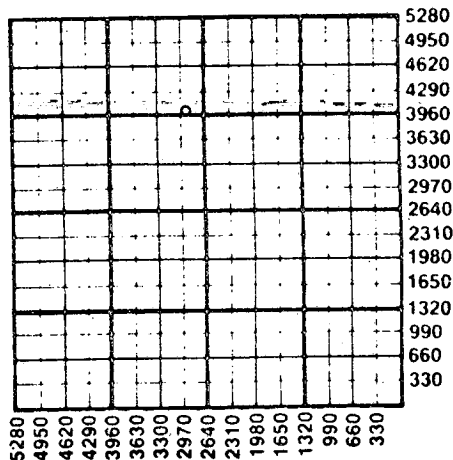

WATER SUPPLY INFORMATION

Disposition of Produced Water: Disposal
Docket # NA Repressuring

Questions on this portion of the ACO-1 call:

Water Resources Board (913) 296-3717
Source of Water:
Division of Water Resources Permit #
Groundwater Ft North from Southeast Corner (Well) Ft West from Southeast Corner of Sec Twp Rge East West
Surface Water Ft North from Southeast Corner (Stream, pond etc) Ft West from Southeast Corner Sec Twp Rge East West
Other (explain) (purchased from city, R.W.D. #)


INSTRUCTIONS: This form shall be completed in duplicate and filed with the Kansas Corporation Commission, 200 Colorado Derby Building, Wichita, Kansas 67202, within 90 days after completion or recompletion of any well. Rule 82-3-130 and 82-3-107 apply. Information on side two of this form will be held confidential for a period of 12 months if requested in writing and submitted with the form. See rule 82-3-107 for confidentiality in excess of 12 months. One copy of all wireline logs and drillers time log shall be attached with this form. Submit CP-4 form with all plugged wells. Submit CP-111 form with all temporarily abandoned wells.

All requirements of the statutes, rules and regulations promulgated to regulate the oil and gas industry have been fully complied with and the statements herein are complete and correct to the best of my knowledge.

Signature H. G. McMahon, III
Title Geologist Date 11-1-85

Subscribed and sworn to before me this 1st day of November 1985
Notary Public Carmen Froelich

Date Commission Expires

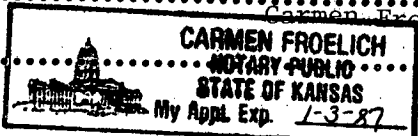

K.C.C. OFFICE USE ONLY
F Letter of Confidentiality Attached
C Wireline Log Received
C Drillers Timelog Received
Distribution
KCC SWD/Rep NGPA
KGS Plug Other (Specify)

RECEIVED STATE CORPORATION COMMISSION Form ACO-1 (7-84)

NOV 18 1985
11-18-85

Operator Name Range Oil Company, Inc. Lease Name..... Fouston Well #..... 1.....

Sec..... 2 Twp..... 26S Rge..... 3 East West County..... Butler

WELL LOG

INSTRUCTIONS: Show important tops and base of formations penetrated. Detail all cores. Report all drill stem tests giving interval tested, time tool open and closed, flowing and shut-in pressures, whether shut-in pressure reached static level, hydrostatic pressures, bottom hole temperature, fluid recovery, and flow rates if gas to surface during test. Attach extra sheet if more space is needed. Attach copy of log.

Drill Stem Tests Taken Yes No
 Samples Sent to Geological Survey Yes No
 Cores Taken Yes No

Formation Description
 Log Sample

DST (1) 2716-2726 30-30-60-60 Blow: wk Rec:150'
 SW IFP 76-63 ISIP 148 FFP 95-84 FSIP
 148 T:109°F


Name	Top	DATUM
Lans	1940	- 649
B Lans	2111	- 820
KC	2241	- 950
BKC	2404	-1113
Marm	2477	-1184
Ck	2634	-1343
Cgl	2693	-1402
Miss	2715	-1424
M Os	2759	-1468
RTD	2765	-1474

CASING RECORD <input checked="" type="checkbox"/> New <input type="checkbox"/> Used							
Report all strings set-conductor, surface, intermediate, production, etc.							
Purpose of String	Size Hole Drilled	Size Casing Set (in O.D.)	Weight Lbs/Ft.	Setting Depth	Type of Cement	#Sacks Used	Type and Percent Additives
Surface	12.25	8.625	23	218	Common	150	3% CaCl
PERFORATION RECORD				Acid, Fracture, Shot, Cement Squeeze Record			
Shots Per Foot	Specify Footage of Each Interval Perforated			(Amount and Kind of Material Used)		Depth	
TUBING RECORD				Size	Set At	Packer at	Liner Run <input type="checkbox"/> Yes <input checked="" type="checkbox"/> No
Date of First Production	Producing Method <input type="checkbox"/> Flowing <input type="checkbox"/> Pumping <input type="checkbox"/> Gas Lift <input type="checkbox"/> Other (explain).....						
Estimated Production Per 24 Hours	Oil Bbls	Gas MCF	Water Bbls	Gas-Oil Ratio	Gravity		

METHOD OF COMPLETION

Production Interval

Disposition of gas: Vented Open Hole Perforation
 Sold Other (Specify)
 Used on Lease

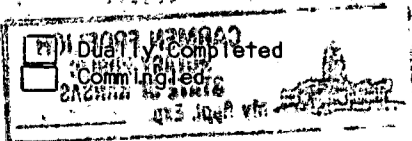

STATE CORPORATION COMMISSION OF KANSAS
OIL & GAS CONSERVATION DIVISION
WELL COMPLETION OR RECOMPLETION FORM
ACO-1 WELL HISTORY
DESCRIPTION OF WELL AND LEASE

Operator: License # 5120
Name Range Oil Company, Inc.
Address 240 Page Court
220 West Douglas
City/State/Zip Wichita, Kansas 67202

Purchaser NONE

Operator Contact Person John Washburn
Phone (316) 265-6231

Contractor: License # 5124
Name Range Drilling Co.

Wellsite Geologist Bob Olsen
Phone (316) 265-6231

Designate Type of Completion

New Well Re-Entry Workover
 Oil SWD Temp Abd
 Gas Inj Delayed Comp.
 Dry Other (Core, Water Supply etc.)

If OMWO: old well Info as follows:

Operator
Well Name
Comp. Date Old Total Depth

WELL HISTORY

Drilling Method:

Mid Rotary Air Rotary Cable

10-25-85 10-30-85 10-31-85
Spud Date Date Reached TD Completion Date

2765 NONE
Total Depth PBDT

Amount of Surface Pipe Set and Cemented at 218 feet
Multiple Stage Cementing Collar Used? Yes No
If yes, show depth set feet
If alternate 2 completion, cement circulated from feet depth to w/ SX cmt
Cement Company Name
Invoice #

API NO. 15-015-22,806
County Butler
1290' FNL, 2380' FWL, NW
Sec. 2 Twp. 26S Rge. 3 East West

3990 Ft North from Southeast Corner of Section
2900 Ft West from Southeast Corner of Section
(Note: Locate well in section plat below)


Lease Name Foulston Well # 1

Field Name Pauls So.

Producing Formation NONE

Elevation: Ground 1286 KB 1291

Section Plat

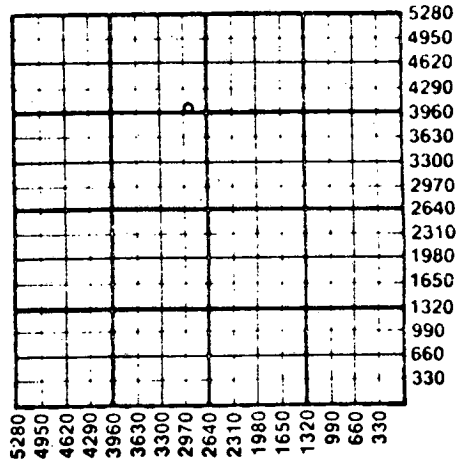

WATER SUPPLY INFORMATION

Disposition of Produced Water: Disposal
Docket # NA Repressuring

Questions on this portion of the ACO-1 call:

Water Resources Board (913) 296-3717

Source of Water:
Division of Water Resources Permit #

Groundwater Ft North from Southeast Corner (Well) Ft West from Southeast Corner of Sec Twp Rge East West

Surface Water Ft North from Southeast Corner (Stream, pond etc) Ft West from Southeast Corner Sec Twp Rge East West

Other (explain) (purchased from city, R.W.D. #)

INSTRUCTIONS: This form shall be completed in duplicate and filed with the Kansas Corporation Commission, 200 Colorado Derby Building, Wichita, Kansas 67202, within 90 days after completion or recompletion of any well. Rule 82-3-130 and 82-3-107 apply. Information on side two of this form will be held confidential for a period of 12 months if requested in writing and submitted with the form. See rule 82-3-107 for confidentiality in excess of 12 months. One copy of all wireline logs and drillers time log shall be attached with this form. Submit CP-4 form with all plugged wells. Submit CP-111 form with all temporarily abandoned wells.


All requirements of the statutes, rules and regulations promulgated to regulate the oil and gas industry have been fully complied with and the statements herein are complete and correct to the best of my knowledge.

Signature H. G. McMahon, III
Title Geologist Date 11-1-85

Subscribed and sworn to before me this 1st day of November 1985

Notary Public Carmen Froelich

Date Commission Expires

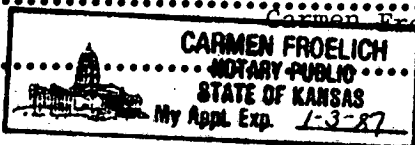

K.C.C. OFFICE USE ONLY
F Letter of Confidentiality Attached
C Wireline Log Received
C Drillers Timelog Received
Distribution
KCC SWD/Rep NGPA
KGS Plug Other (Specify)

RECEIVED STATE CORPORATION COMMISSION FORM ACO-1 (7-84)

NOV 5 1985

SIDE TWO

Operator Name Range Oil Company, Inc. Lease Name..... Fouston Well #..... 1.....

Sec..... 2 Twp..... 26S Rge..... 3 East West County..... Butler

WELL LOG

INSTRUCTIONS: Show important tops and base of formations penetrated. Detail all cores. Report all drill stem tests giving interval tested, time tool open and closed, flowing and shut-in pressures, whether shut-in pressure reached static level, hydrostatic pressures, bottom hole temperature, fluid recovery, and flow rates if gas to surface during test. Attach extra sheet if more space is needed. Attach copy of log.

Drill Stem Tests Taken Yes No
 Samples Sent to Geological Survey Yes No
 Cores Taken Yes No

DST (1) 2716-2726 30-30-60-60 Blow: wk Rec:150'
 SW IFP 76-63 ISIP 148 FFP 95-84 FSIP
 148 T:109°F

Formation Description		DATUM
Name	Top	Depth
Lans	1940	- 649
B Lans	2111	- 820
KC	2241	- 950
BKC	2404	-1113
Marm	2477	-1184
Ck	2634	-1343
Cgl	2693	-1402
Miss	2715	-1424
M Os	2759	-1468
RTD	2765	-1474

CASING RECORD <input checked="" type="checkbox"/> New <input type="checkbox"/> Used							
Report all strings set-conductor, surface, intermediate, production, etc.							
Purpose of String	Size Hole Drilled	Size Casing Set (In O.D.)	Weight Lbs/Ft.	Setting Depth	Type of Cement	#Sacks Used	Type and Percent Additives
Surface	12.25	8.625	23	218	Common	150	3% CaCl
PERFORATION RECORD				Acid, Fracture, Shot, Cement Squeeze Record			
Shots Per Foot	Specify Footage of Each Interval Perforated			(Amount and Kind of Material Used)			Depth
TUBING RECORD				Liner Run	<input type="checkbox"/> Yes <input checked="" type="checkbox"/> No		
Date of First Production	Producing Method						
	<input type="checkbox"/> Flowing <input type="checkbox"/> Pumping <input type="checkbox"/> Gas Lift <input type="checkbox"/> Other (explain).....						
Estimated Production Per 24 Hours	Oil	Gas	Water	Gas-Oil Ratio	Gravity		
	Bbls	MCF	Bbls	CFPB			

METHOD OF COMPLETION Production Interval

Disposition of gas: Vented Open Hole Perforation
 Sold Other (Specify)
 Used on Lease

