STATE OF KANSAS KANSAS CORPORATION COMMISSION CONSERVATION DIVISION 130 South Market - Room 2078 Wichita, Kansas 67202

FORM CP-1 (3/92)

WELL PLUGGING APPLICATION FORM (PLEASE TYPE FORM and File ONE Copy)

API # 15-015-21588-00-60
wells drilled since 1967; if no API# was issued, indicate spud or completion date.
ADDRESS 3223 FNGLOH CITY WICHITA (operator's)
STATE ZIP CODE <u>67218</u> CONTACT PHONE # (316) <u>686-0227</u>
LEASE NORSCONE WELL# 1 SEC. 10 T. 26 R. 3 (Easy/West)
NW-NE NE SPOT LOCATION/0000 COUNTY BUTLER
4950 FEET (in exact footage) FROM S/N (circle one) LINE OF SECTION (NOT Lease Line)
990 FEET (in exact footage) FROM (E) W (circle one) LINE OF SECTION (NOT Lease Line)
Check One: OIL WELL X GAS WELL D&A SWD/ENHR WELL DOCKET#
CONDUCTOR CASING SIZE SET AT CEMENTED WITH SACKS
SURFACE CASING SIZE 858 SET AT 200+ CEMENTED WITH SACKS
PRODUCTION CASING SIZE 4/2 SET AT 2756 CEMENTED WITH SACKS
LIST (ALL) PERFORATIONS and BRIDGEPLUG SETS: 2720 - 2722
ELEVATION 1315 T.D. 2757PBTD 2757ANHYDRITE DEPTH
T.D. ANHYDRITE DEPTH (Stone Corial Formation) CONDITION OF WELL: GOOD X POOR CASING LEAK JUNK IN HOLE CORPORATION COMMISSION
(If additional space is needed attach separate page) CONSERVATION DIVISION IS WELL LOG ATTACHED TO THIS APPLICATION AS REQUIRED? VES IS ACO-1 FILED?
IS WELL LOG ATTACHED TO THIS APPLICATION AS REQUIRED? YES IS ACO-1 FILED? WICH TO THIS APPLICATION AS REQUIRED?
If not explain why?
PLUGGING OF THIS WELL WILL BE DONE IN ACCORDANCE WITH K.S.A. 55-101 <u>et. seq</u> . AND THE RULES AND REGULATIONS OF THE STATE CORPORATION COMMISSION.
LIST NAME OF COMPANY REPRESENTATIVE AUTHORIZED TO BE IN CHARGE OF PLUGGING OPERATIONS:
D.S. LANGSTON PHONE# 86 686-0227 on 265-4411
ADDRESS 3223 ENGLISH City/State WICHITA, KS 67218
PLUGGING CONTRACTOR KC Developmen Inc KCC LICENSE # 301115/97
ADDRESS KR BOXS6 Florence KS PHONE # 319 878-4323
PROPOSED DATE AND HOUR OF PLUGGING (If Known?)
PAYMENT OF THE PLUGGING FEE (K.A.R. 82-3-118) WILL BE GUARANTEED BY OPERATOR OR AGENT
DATE:AUTHORIZED OPERATOR/AGENT:
(signature)

15-015-21588


		Subt	err	anea	n l	oggi	ing Inc).	
				Radio	activ	ity Lo	g		
FILING NO.		COMPAN					JM INC.		*****
		FIELD_					STATE_	KAN	SAS
	f	LOCATION:					31416	OTHER SE	-
·		sec. 9		TWP	2ós	RGE	3E		
PERMANENT DA LOG MEASURED DRILLING MEAS	FRO	м_ К.Е					1310' ERM. DATUM	D.I	1315
DATE RUNNO.			1-8 ONE	8-81					
TYPE ZOG DEPTH-DRILLE	R		GAMN 274	A RAY		NEUTR	ON	CEMENT	LOG
DE -LOGGER	?	TERVAL	274	161		27	45'		
TOP LOGGED IN				50			56 '		
SOURCE MODEL	NO.		MRC Am-2	-N-SS	– W		-63 CURIE		
SOURCE STRENG SOURCE SERIAL OPERATING RIG	NO		414 NON	5		5.4 X 10	-3 CURIE	<u> </u>	
RECORDED BY WITNESSED BY			I.L.	SULL	IVAN		· · · · · · · · · · · · · · · · · · ·		
AEC LICENSE N	ο.			-140-01				1	
	3OR	E-HOLE F	ECO				CASING F		
NO. BIT		FROM	1	то		SIZE	wg⊤. 9 <u>\$</u> #	FROM O'	2750
			-		1				
					+				

LOUD III KE				HES OF ACRESSA	THE HEADING AND LOGGED OFFICENS FOR THE RE-		
					LOGGING DATA		
	GENERAL				GAMMA RAY		NEUTRON
4 i	DEPTHS	SPEED T.C.	T.C.	SENS.	ZERO DIV. L OR R	T.C. SENS.	ZERO DIV. L OR R
FROM	01	. I . / MIN		SELLINGS	1 6		1
2707.2	2250	2	\neg	5.7		1_	
REFERENCE L	ITERATURE D	ERCPORAT	ED A	11:11 33	REFERENCE LITERATURE FERCECKATED 419H 3 D.W.L. JETS FROM 2720 10 2722' - 4 HOLES	20 TO 2722	· - 4 HOLES
REMARKS							
GAM	GAMMA RAY	۸Y	DEPTH	TH	NECTRON		CASING

API UNITS

API UNITS

2300

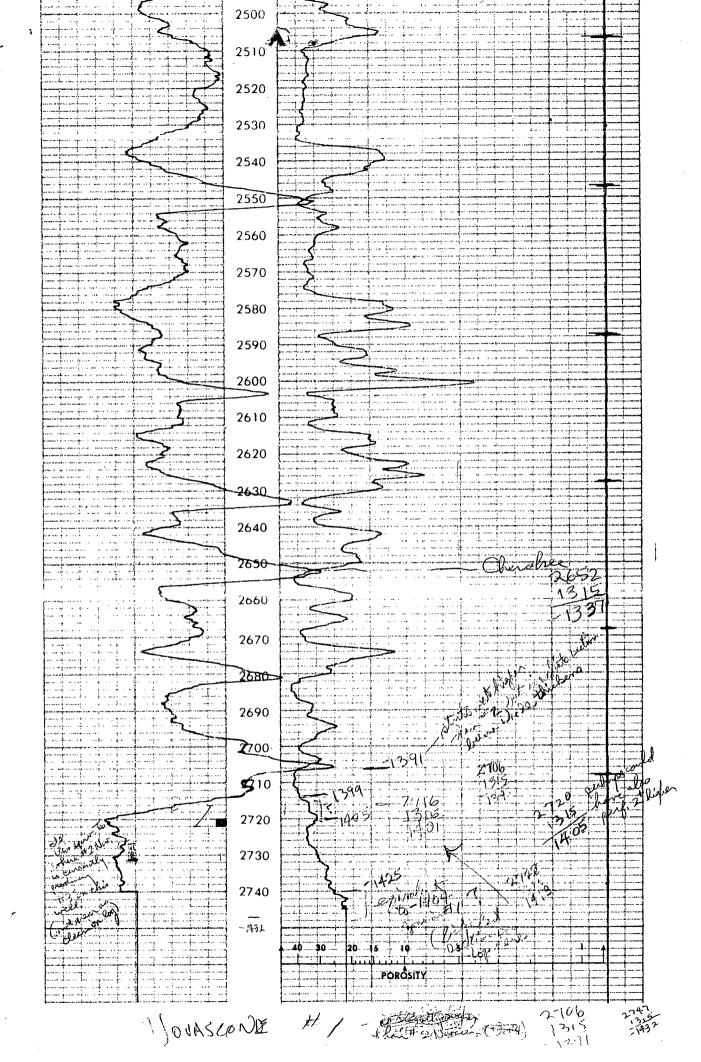



Kansas Corporation Commission

Bill Graves, Governor Timothy E. McKee, Chair Susan M. Seltsam, Commissioner John Wine, Commissioner Judith McConnell, Executive Director David J. Heinemann, General Counsel

NOTICE OF RECEIPT OF WELL PLUGGING APPLICATION (CP-1)

July 23, 1996

K C Development Inc RR 1 Box 52B Florence KS 66851 Novascone #1 API #15-015-21,588 4950 FNL 990 FEL Sec. 10-26S-03E Butler County

Dear Rex Savage,

This letter is to notify you that the Conservation Division is in receipt of your plugging proposal, form CP-1, for the above-captioned well.

Your CP-1 has been reviewed by the Conservation Division central office for completeness and to verify license numbers. The plugging proposal will now be forwarded to the district office listed below for review of your proposed method of plugging.

Please contact the district office for approval of your proposed plugging method at least at five (5) days before plugging the well, pursuant to K.A.R. 82-3-113 (b). If a workover pit will be used during the plugging of the well it must be permitted. A CDP-1 form must be filed and approved prior to the use of the pit.

The Conservation Division's review of form CP-1, either in the central or district office, does not include an inquiry into well ownership or the filing operator's legal right to plug the well.

This notice in no way constitutes authorization to plug the above-captioned well by persons not having legal rights of ownership or interest in the well. This notice is void after ninety (90) days from the above date.

> David P. Williams Production Supervisor

District: #2 130 S. Market Room 2125 Wichita KS 67202-3208 (316) 337-6231