

STATE OF KANSAS
STATE CORPORATION COMMISSION


WELL PLUGGING RECORD

Give All Information Completely
Make Required Affidavit
Mail or Deliver Report to:
Conservation Division
State Corporation Commission
800 Bitting Building
Wichita, Kansas

Butler County, Sec. 10 Twp. 26S Rge. 3E (E) (W)

Location as "NE/CNWxSWx" or footage from lines NW NW SW
Lease Owner Eureka Drilling Company
Lease Name Black Well No. 1
Office Address HAMILTON, KANSAS
Character of Well (completed as Oil, Gas or Dry Hole) dry hole
Date well completed December 1 19 66
Application for plugging filed December 1 19 66
Application for plugging approved December 1 19 66
Plugging commenced December 1 19 66
Plugging completed December 1 19 66
Reason for abandonment of well or producing formation dry

NORTH

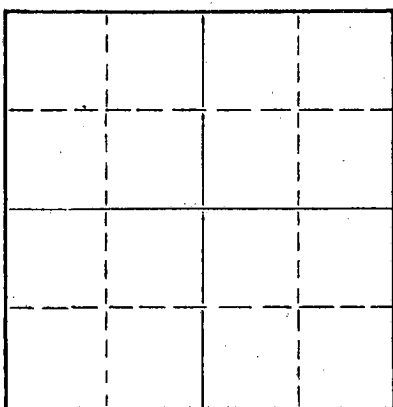

Locate well correctly on above Section Plat

If a producing well is abandoned, date of last production 19
Was permission obtained from the Conservation Division or its agents before plugging was commenced? yes

Name of Conservation Agent who supervised plugging of this well Paul Turpin
Producing formation _____ Depth to top _____ Bottom _____ Total Depth of Well 2850 Feet
Show depth and thickness of all water, oil and gas formations.

OIL, GAS OR WATER RECORDS

CASING RECORD

FORMATION	CONTENT	FROM	TO	SIZE	PUT IN	PULLED OUT

Describe in detail the manner in which the well was plugged, indicating where the mud fluid was placed and the method or methods used in introducing it into the hole. If cement or other plugs were used, state the character of same and depth placed, from _____ feet to _____ feet for each plug set.

Mud to 200' plug 1/2 sack hulls & 20 sacks cement
Mud to 35' plug 1/2 sack hulls and 8 sacks cement.
Plug rat hole w/ 2 sacks cement

RECEIVED
STATE CORPORATION COMMISSION
DEC 20 1966
12-20-66
CONSERVATION DIVISION
Wichita, Kansas


(If additional description is necessary, use BACK of this sheet)

Name of Plugging Contractor Eureka Drilling Company
Address Hamilton, Kansas

STATE OF Kansas, COUNTY OF Greenwood, ss.
Eureka Drilling Company (employee of owner) or (owner or operator) of the above-described well, being first duly sworn on oath, says: That I have knowledge of the facts, statements, and matters herein contained and the log of the above-described well as filed and that the same are true and correct. So help me God.

(Signature) Henry Martell
(Address) _____

SUBSCRIBED AND SWORN to before me this 19 day of Dec, 19 66
Walker Ellis Notary Public
Greenwood County, Kansas
My commission expires Commission Expires Aug. 9, 1970

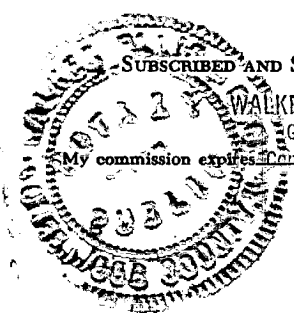

Notary Public.

②

Company	Eureka Drilling Company & Charles Gould
Farm	Black
Well	NO. 1
Location	NW NW SW SEC 10-26-2 Butler County, Kansas
Date	Commenced: November 26, 1966 Completed: December 1, 1966
Casing Record	126' of 7" surface casing
Elevation	1245 ground
Contractor	Eureka Drilling Company Hamilton, Kansas Riq #2

0 - 20	soil & clay	2850	lime w/shale strks
40	shale & shells		
135	lime w/shale	R.T.D.	
245	lime w/shale strks		
295	lime --hard		
325	lime w/shale strks		
415	lime--broken		
420	red bed		
435	lime broken		
480	lime		
490	lime w/shale		
690	lime w/shale strks		
735	shale & lime		
1050	shale w/lime strks		
1085	sand & shale		
1090	shale		
1195	shale & shells		
1215	sand		
1340	shale & shells		
1400	shale w/lime strks		
1430	shale & shells		
1485	lime		
1620	lime & shale		
1642	sand & lime		
1674	lime		
1810	lime & shale		
1859	sand & shale		
1918	shale		
1940	lime & shale		
1960	shale		
2018	lime		
2049	lime & shale strks		
2097	sandy lime & shale		
2185	sandy shale		
2339	shale		
2402	lime w/shale strks		
2485	lime		
2505	shale w/limestrks		
2643	shale, redbed, lime strks		
2770	shale		
2782	limew/shale strks		
2831	lime		
2850	lime w/shale strks		

RECEIVED
 STATE CONSERVATION COMMISSION
 AUG 29 1966
 CONSERVATION DIVISION
 Wichita, Kansas