


STATE OF KANSAS
STATE CORPORATION COMMISSION

WELL PLUGGING RECORD

Give All Information Completely
Make Required Affidavit
Mail or Deliver Report to:
Conservation Division
State Corporation Commission
211 No. Broadway
Wichita, Kansas

Butler County, Sec. 18 Twp. 26 Rge. 3 (E) (W)

NORTH

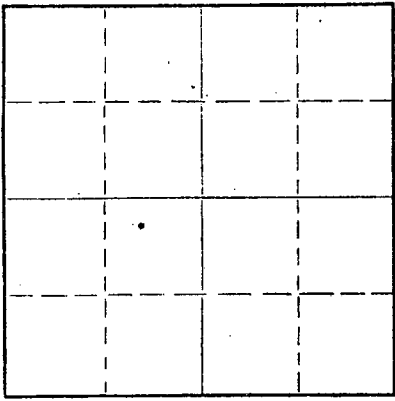

Locate well correctly on above
Section Plat

Location as "NE/CNW/SW" or footage from lines nw/ne/sw
Lease Owner Winne Oil Co % Kent Well Servicing Co
Lease Name Lygrisse # D-1 Well No. _____
Office Address Box 667 El Dorado, Kansas
Character of Well (completed as Oil, Gas or Dry Hole) Oil
Date well completed 6-15-57 19____
Application for plugging filed Nov. 5, 1958 19____
Application for plugging approved Nov. 7, 1958 19____
Plugging commenced 11-11-58 1:30 pm 19____
Plugging completed 11-13-58 5:00 pm 19____
Reason for abandonment of well or producing formation stopped producing profitable
If a producing well is abandoned, date of last production _____ 19____
Was permission obtained from the Conservation Division or its agents before plugging was commenced? yes

Name of Conservation Agent who supervised plugging of this well _____
Producing formation Miss Chat Depth to top 2884 Bottom 2886 Total Depth of Well 2935 Feet
Show depth and thickness of all water, oil and gas formations.

OIL, GAS OR WATER RECORDS

CASING RECORD

FORMATION	CONTENT	FROM	TO	SIZE	PUT IN	PULLED OUT
				8 5/8	199'	cemented
				4 1/2"	2933'	2435'


Describe in detail the manner in which the well was plugged, indicating where the mud fluid was placed and the method or methods used in introducing it into the hole. If cement or other plugs were used, state the character of same and depth placed, from _____ feet to _____ feet for each plug set.

2882' dumped 5 sacks cement wet with bailer
200'-10' rock bridge - 15 sacks cement wet with bailer
mudded to 20'
20' - 5' rock - 5 sacks cement - dumped dry
pipe perforated 2884' - 2886'

(If additional description is necessary, use BACK of this sheet)
Name of Plugging Contractor Kent Well Servicing Co
Address Box 667 El Dorado, Kansas # 394

STATE OF Kansas, COUNTY OF Butler, ss.
C. D. Payne (employee of owner) or (owner or operator) of the above-described well, being first duly sworn on oath, says: That I have knowledge of the facts, statements, and matters herein contained and the log of the above-described well as filed and that the same are true and correct. So help me God.

(Signature) C. D. Payne
Box 667 El Dorado, Kansas (Address)

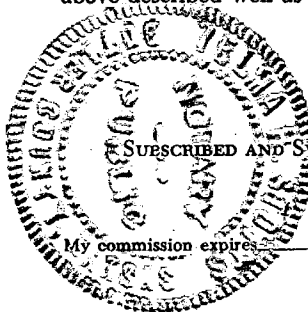

SUBSCRIBED AND SWORN TO before me this 29th day of November 1958
3-14-1960 My commission expires

RECEIVED
STATE CORPORATION COMMISSION
DEC 5 - 1958
12-5-58
Notary Public.
CONSERVATION DIVISION
Wichita, Kansas

PLUGGING
FILE SEC. 18 T. 26 R. 3E
BOOK PAGE 143 LINE 22