

STATE OF KANSAS
STATE CORPORATION COMMISSION


WELL PLUGGING RECORD

Give All Information Completely
Make Required Affidavit
Mail or Deliver Report to:
Conservation Division
State Corporation Commission
211 No. Broadway
Wichita, Kansas

Butler County, Sec. 18 Twp. 26 Rge. 3 (E) (W)

Location as "NE/CNW/SW" or footage from lines ne - nw - sw
Lease Owner Winne Oil Co % Kent Well Servicing Co
Lease Name Lygrisse # 1-B Well No.
Office Address Box 667 El Dorado, Kansas
Character of Well (completed as Oil, Gas or Dry Hole) Oil
Date well completed 3-23-57 19
Application for plugging filed Nov. 5 - 1958 19
Application for plugging approved Nov. 7 - 1958 19
Plugging commenced 11-10-58 7:30 am 19
Plugging completed 11-11-58 12:30 pm 19
Reason for abandonment of well or producing formation stopped producing

NORTH

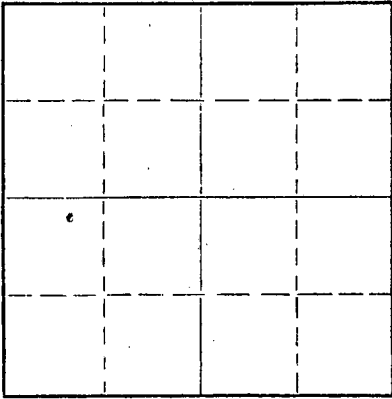

Locate well correctly on above
Section Plat

If a producing well is abandoned, date of last production 19
Was permission obtained from the Conservation Division or its agents before plugging was commenced? yes

Name of Conservation Agent who supervised plugging of this well Lee Guthrie
Producing formation miss chat Depth to top 2875 Bottom 2893 Total Depth of Well 2930 Feet
Show depth and thickness of all water, oil and gas formations.

OIL, GAS OR WATER RECORDS

CASING RECORD

FORMATION	CONTENT	FROM	TO	SIZE	PUT IN	PULLED OUT
				102'	8 5/8"	cemented
				2928'	4 1/2"	2408'

Describe in detail the manner in which the well was plugged, indicating where the mud fluid was placed and the method or methods used in introducing it into the hole. If cement or other plugs were used, state the character of same and depth placed, from feet to feet for each plug set.

2880' - dumped 5 sacks cement wet with bailer

180' - 10' rock bridge - 15 sacks cement

mudded to 20'

20' - 5' rock - 5 sacks cement

pipe was perforated 2875 - 2893

(If additional description is necessary, use BACK of this sheet)
Name of Plugging Contractor Kent Well Servicing Co
Address Box 667 El Dorado, Kansas

STATE OF Kansas, COUNTY OF Butler, ss.
G. D. Payne (employee of owner) or (owner or operator) of the above-described

well, being first duly sworn on oath, says: That I have knowledge of the facts, statements, and matters herein contained and the log of the above-described well as filed and that the same are true and correct. So help me God.

(Signature) G. D. Payne

Box 667 El Dorado, Kansas

SUBSCRIBED AND SWORN TO before me this 29th day of November 1958

Notary Public
J. Edward H. Stalla
STATE CORPORATION COMMISSION

My commission expires 3-14-1960

RECEIVED
DEC 5 - 1958
12-5-58
CONSERVATION DIVISION
Wichita, Kansas

PLUGGING
FILE SEC 18 T 26 R 3E
BOOK PAGE 143 LINE 21

