


STATE OF KANSAS  
STATE CORPORATION COMMISSION

WELL PLUGGING RECORD

Give All Information Completely  
Make Required Affidavit  
Mail or Deliver Report to:  
Conservation Division  
State Corporation Commission  
211 No. Broadway  
Wichita, Kansas

BUTLER County. Sec. 26 Twp. 26S Rge. 3E (E) (W)

Location as "NE/CNW/SW" or footage from lines SE-NE-SW  
Lease Owner J. P. GATY  
Lease Name BAILEY Well No. 1  
Office Address 11 CYPRESS DRIVE WICHITA, KANSAS  
Character of Well (completed as Oil, Gas or Dry Hole) DRY HOLE  
Date well completed: MARCH 14, 1958 19  
Application for plugging filed 3-14-58 19  
Application for plugging approved 19  
Plugging commenced 3-14-58 19  
Plugging completed 3-14-58 19  
Reason for abandonment of well or producing formation DRY HOLE

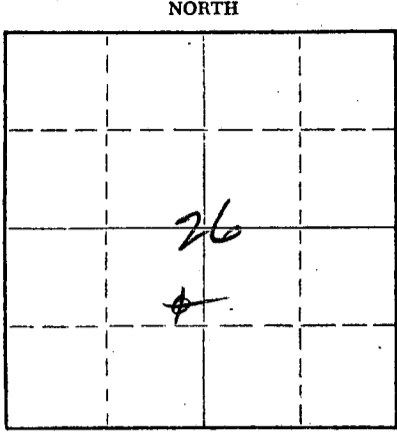

Locate well correctly on above Section Plat

If a producing well is abandoned, date of last production 19  
Was permission obtained from the Conservation Division or its agents before plugging was commenced? YES

Name of Conservation Agent who supervised plugging of this well DELBERT HARTER  
Producing formation SIMPSON Depth to top 3085 Bottom 3090 Total Depth of Well 3090 Feet  
Show depth and thickness of all water, oil and gas formations.

OIL, GAS OR WATER RECORDS

CASING RECORD

FORMATION	CONTENT	FROM	TO	SIZE	PUT IN	PULLED OUT
<u>WATER</u>		<u>100</u>	<u>110</u>	<u>8 5/8</u>	<u>204</u>	<u>CEMENTED</u>

Describe in detail the manner in which the well was plugged, indicating where the mud fluid was placed and the method or methods used in introducing it into the hole. If cement or other plugs were used, state the character of same and depth placed, from 200 feet to 180 feet for each plug set.

REAL HEAVY MUD PUMPED IN HOLE & CIRCULATED TO TOP OF HOLE.  
BRIDGE PLACED AT 200 FT. 15 SACKS CEMENT. FILLED HOLE WITH  
HEAVY MUD TO 20 FT. MIXED 5 SACKS OF CEMENT AND PUT IN HOLE.  
CUT OFF SURFACE PIPE BELOW PLOW DEPTH.

(If additional description is necessary, use BACK of this sheet)  
Name of Plugging Contractor GLEN DRILLING, INC.  
Address Box 547 EL DORADO, KANSAS

STATE OF KANSAS COUNTY OF BUTLER, ss.  
GLEN GAINES (employee of owner) or (owner or operator) of the above-described well, being first duly sworn on oath, says: That I have knowledge of the facts, statements, and matters herein contained and the log of the above-described well as filed and that the same are true and correct. So help me God

(Signature) Glen Gaines  
Box 547 EL DORADO, KANSAS  
(Address)

SUBSCRIBED AND SWORN TO before me this 17 day of MARCH, 19 58

My commission expires JUNE 21, 1961  
Alma M. Wentworth  
Notary Public.

PLUGGING  
FILED 26 T. 26 R. 3E  
BOOK PAGE 89 LINE 19

MAR 1 1958  
CONSERVATION DIVISION  
Wichita, Kansas

RECORDED  
MAR 18 1958  
3-18-58  
CONSERVATION DIVISION  
Wichita, Kansas

WELL LOG

COMPANY J. P. GATY  
11 CYPRESS DRIVE  
WICHITA, KANSAS

LOCATION:  
SE-NE-SW  
SECTION 26-26S-3E  
BUTLER COUNTY, KANS.

CONTRACTOR GLEN DRILLING, INC.  
BOX 547  
EL DORADO, KANSAS

FARM BAILEY

DATE COMM MARCH 5, 1958

DATE COMP MARCH 14, 1958

TOTAL DETPH 3090' 204' OF 8 5/8" SURFACE-CEMENTED

FROM	To	
0	20	SOIL & CLAY
20	100	SHALE & SHELES
100	160	SHALE & LIME STREAKS
160	190	SAND & SHALE
190	204	LIME
204	645	LIME & SHALE
645	1015	SHALE & LIME STREAKS
1015	1785	SHALE & LIME
1785	1845	SAND & SHALE STREAKS
1845	1906	SHALE & SANDY SHALE STREAKS
1906	1940	SHALE
1940	1965	LIME & SHALE
1965	2005	SHALE & LIME STREAKS
2005	2162	LIME & SHALE STREAKS
2162	2292	SHALE & LIME STREAKS
2292	2451	LIME
2451	2712	LIME & SHALE
2712	2729	SHALE & SHELLS
2729	2746	CONG.
2746	2769	LIME & CHERT MISS
2769	2994	LIME & CHERT
2994	3033	SHALE & LIME
3033	3068	SHALE
3068	3085	VIOLA LIME
3085	3090	SIMPSON
	3090	TOTAL DEPTH

I HEREBY CERTIFY THAT THE FOREGOING IS A TRUE AND CORRECT COPY OF THE WELL LOG FOR THE BAILEY # 1 WELL DRILLED FOR MR. J. P. GATY AND COMPLETED MARCH 14, 1958.

GLEN DRILLING, INC.  
*Glen Gaines*  
GLEN GAINES, PRESIDENT

STATE OF KANSAS )SS  
COUNTY OF BUTLER)

SUBSCRIBED AND SWORN TO BEFORE THE UNDERSIGNED, A NOTARY PUBLIC IN AND FOR COUNTY AND STATE AFORESAID THE 17TH DAY OF MARCH 1958.

*Alona M. Wentworth*  
ALONA M. WENTWORTH, NOTARY PUBLIC.

MY COMMISSION EXPIRES JUNE 21, 1961.

RECORDED  
26 26 35  
MAR 29 1958