


STATE OF KANSAS
STATE CORPORATION COMMISSION

Give All Information Completely
Make Required Affidavit
Mail or Deliver Report to:
Conservation Division
State Corporation Commission
212 North Market, Insurance Bldg.
Wichita, Kansas

WELL PLUGGING RECORD

NORTH

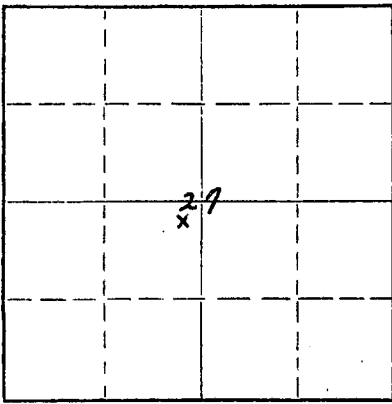

Locate well correctly on above
Section Plat

Butler County, Sec. 27 Twp. 26S Rge. 3 (E) (W)
Location as "NE/CNW/SW" or footage from lines 330'S - 330' W of Center
Lease Owner Cities Service Oil Co.
Lease Name Thacker Well No. 1
Office Address Box 31, Augusta, Kansas
Character of Well (completed as Oil, Gas or Dry Hole) Dry Hole
Date well completed 4-7 19 60
Application for plugging filed 4-6 19 60
Application for plugging approved 4-7 19 60
Plugging commenced 4-7 19 60
Plugging completed 4-7 19 60
Reason for abandonment of well or producing formation Dry Hole

If a producing well is abandoned, date of last production 19
Was permission obtained from the Conservation Division or its agents before plugging was commenced? Yes

Name of Conservation Agent who supervised plugging of this well Eugene Graham
Producing formation _____ Depth to top _____ Bottom _____ Total Depth of Well 3250 Feet
Show depth and thickness of all water, oil and gas formations.

OIL, GAS OR WATER RECORDS

CASING RECORD

FORMATION	CONTENT	FROM	TO	SIZE	PUT IN	PULLED OUT
Log Attached				10 3/4"	305'	None

Describe in detail the manner in which the well was plugged, indicating where the mud fluid was placed and the method or methods used in introducing it into the hole. If cement or other plugs were used, state the character of same and depth placed, from _____ feet to _____ feet for each plug set.

Mud from 3250' T.D. to 300', Bridge with wood plug and hulls at 300', Dump 25 sacks of cement from 300' to 247', mud from 247' to 25', wood plug-hulls and 12 sacks of cement from 25' to surface, bridged rat hole and dump 2 sacks of cement.

RECEIVED
STATE CORPORATION COMMISSION
4-19-60
APR 19 1960
CONSERVATION DIVISION
Wichita, Kansas

(If additional description is necessary, use BACK of this sheet)

Name of Plugging Contractor White and Ellis Drilling, Inc.
Address Box 448, El Dorado, Kansas

STATE OF KANSAS, COUNTY OF BUTLER, ss.
E. W. PETERMAN (employee of owner) or (owner or operator) of the above-described well, being first duly sworn on oath, says: That I have knowledge of the facts, statements, and matters herein contained and the log of the above-described well as filed and that the same are true and correct. So help me God.

(Signature) E. W. Peterman
BOX 31, Augusta, Kansas
(Address)

SUBSCRIBED AND SWORN TO before me this 16th day of April, 1960
Glenn R. Carmack
Notary Public.



18
4/17/60

Casing Record

10 3/4

315' Cemented
w/250 sacks

R

Location: C-NE NE SW
Section: 27-26-3E.
Butler County, Kansas

Farm: Thacker #1
Well Owner: Cities Service Oil Co.
Contractor: White & Ellis Drig., Inc
Started: 3/25/60
Completed: 4/7/60

T.D.

3250'

Kelly Bushing Measurement 5' above ground level.

FORMATION	DEPTH
Soll	0-5
Lime & Shale stks.	45
Lime	155
Lime & Shale	260
Lime	270
Ft. Riley Lime	313
Lime	545
Shale & Lime	1160
Shale & Shells	1210
Lime & Shale	1660
Lime	1776
Shale	1855
Sand	1890
Sdy. Shale	1905
Shale	1972
Lime	2175
Shale	2244
Shale & Lime stks.	2326
Lime	2494
Shale & Lime stks.	2571
Lime & Shale	2745
Shale Conglomerate	2785
Lime	3057
Shale	3108
Lime	3158
Sand	3211
Lime	3250

TOPS

Douglass	1855
Lansing	1972
Kansas City Conglomerate	2326 2745
Mississippi Kinderhook	2785 3057
Viola Simpson	3108 3160
Arbuckle	3211

RECEIVED
STATE CORPORATION COMMISSION
APR 19 1960
CONSERVATION DIVISION
Wichita, Kansas

Dry Hole
Plugged & Abandoned