


STATE OF KANSAS
STATE CORPORATION COMMISSION

WELL PLUGGING RECORD

Give All Information Completely
Make Required Affidavit
Mail or Deliver Report to:
Conservation Division
State Corporation Commission
800 Bitting Building
Wichita, Kansas

Butler County, Sec. 29 Twp. 26S Rge. 3 (E) (W)
Location as "NE/CNW 1/4 SW 1/4" or footage from lines SE SE SW
Lease Owner Rex & Morris Drilling Company
Lease Name Anderson Well No. 1
Office Address Box 334, El Dorado, Kansas
Character of Well (completed as Oil, Gas or Dry Hole) Dry Hole
Date well completed August 4 19 52
Application for plugging filed " 19 "
Application for plugging approved " 19 "
Plugging commenced " 19 "
Plugging completed " 19 "
Reason for abandonment of well or producing formation Dry Hole

NORTH

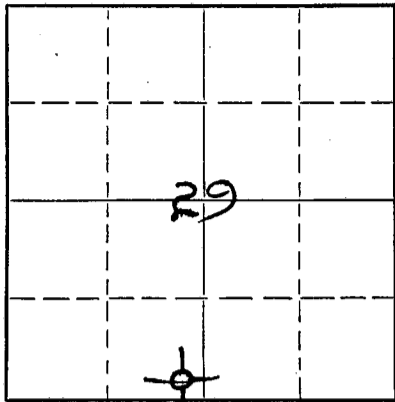

Locate well correctly on above
Section Plat

If a producing well is abandoned, date of last production 19
Was permission obtained from the Conservation Division or its agents before plugging was commenced? Yes

Name of Conservation Agent who supervised plugging of this well Lawrence W. Matthews, 814 W. Olive, El Dorado, Kans.

Producing formation Depth to top Bottom Total Depth of Well 3265 Feet

Show depth and thickness of all water, oil and gas formations.

OIL, GAS OR WATER RECORDS

CASING RECORD

Formation	Content	From	To	Size	Put In	Pulled Out
Surface Hole	Water	0	98	8 5/8"	98	None
See Attached Log.						

Describe in detail the manner in which the well was plugged, indicating where the mud fluid was placed and the method or methods used in introducing it into the hole. If cement or other plugs were used, state the character of same and depth placed, from feet to feet for each plug set.

Mud from 3265 to 200': 10 Sacks of cement on wood plug from 200' to 190':
Mud to Surface with 5 Sacks of cement cap.

(If additional description is necessary, use BACK of this sheet)

Name of Plugging Contractor Rex & Morris Drilling Company
Address Box 334, El Dorado, Kansas

STATE OF Kansas, COUNTY OF Butler, ss.
C. E. McClure (employee of owner) or (owner or operator) of the above-described well,

being first duly sworn on oath, says: That I have knowledge of the facts, statements, and matters herein contained and the log of the above-described well as filed and that the same are true and correct. So help me God.


(Signature) C. E. McClure

El Dorado, Kansas (Address)

SUBSCRIBED AND SWORN to before me this 20th day of August, 19 52

My commission expires July 23, 1956

Winfred E. Pruitt
Notary Public.

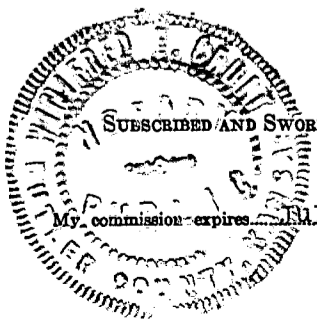

23-8390 STATE CORPORATION COMMISSION

RECEIVED

PLUGGING

FILE SEC 29 T 26 R 36

AUG 21 1952

8-21-52

CONSERVATION DIVISION

BOOK PAGE 37 LINE 10

Elevation - 1343 D. F.
1346 R. B.

ANDERSON WELL # 1

REX & MORRIS DRILLING COMPANY

TOTAL DEPTH	- 3265	LOCATION - SE-SE-SW
CONTRACTOR	- Rex & Morris Drilling Co.	SECTION - 29-26-3E
COMMENCED	- July 26, 1952	BUTLER COUNTY, KANSAS
COMPLETED	- August 4, 1952	CASING RECORD:
INITIAL PRODUCTION	- D. A.	8 5/8 @ 98' w/ 80 sacks

FORMATION	DEPTH
Surface hole	103
Shale, red rock & lime	160
Lime and shale	935
Shale and lime	1110
Shale and shells	1350
Shale and lime	1490
Lime and shale	1700
Shale and lime	2020
Lime and shale	2115
Lime	2220
Shale	2384
Lime - K. C.	2556
Shale and lime	2715
Shale and shells	2782
Lime and shale	2798
Conglomerate	2812
Lime (Mississippi)	3076
Shale	3131
Dolomite (Viola)	3162
Shale and sand (Simpson)	3245
Dolomite (Arbuckle) T. D. R. B.	3265

I hereby certify the foregoing statements are true and correct to the best of my knowledge and belief.

Rex & Morris Drilling Company

STATE CORPORATION COMMISSION

By Paul D. Shony

AUG 2 1952

Title Geologist

CONSERVATION DIVISION
Wichita, Kansas

STATE OF KANSAS)
COUNTY OF BUTLER)

SS

Subscribed and sworn to before me, a Notary Public, this 20th day of August 1952.

PLUGGING
FILE SEC 29-26-3E
BOOK PAGE 37 LINE 0

Winifred E. Overt
Notary Public

My Commission Expires:

July 23, 1956.