

STATE OF KANSAS
STATE CORPORATION COMMISSION

Give All Information Completely
Make Required Affidavit
Mail or Deliver Report to:
Conservation Division
State Corporation Commission
212 North Market, Insurance Bldg.
Wichita, Kansas

WELL PLUGGING RECORD

Butler County, Sec. 26 Twp. 26S Rge. 3 (E) (XX)

Location as "NE/CNW/SW" or footage from lines SW SE NW

Lease Owner Stelbar Oil Corporation, Inc.

Lease Name Colburn Well No. 1

Office Address 310 Petroleum Bldg., Wichita 2, Kansas

Character of Well (completed as Oil, Gas or Dry Hole) dry hole

Date well completed September 9, 19 60

Application for plugging filed September 9, 19 60

Application for plugging approved September 9, 19 60

Plugging commenced September 9, 19 60


Plugging completed September 9, 19 60

Reason for abandonment of well or producing formation _____

no shows

If a producing well is abandoned, date of last production _____ 19 _____

Was permission obtained from the Conservation Division or its agents before plugging was commenced? yes

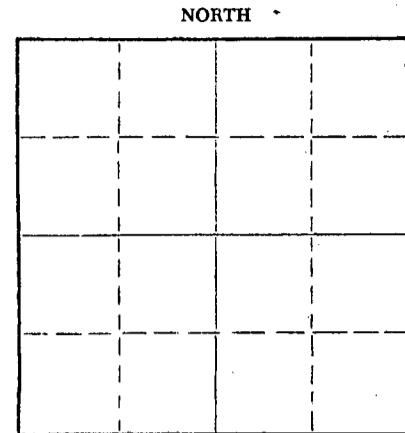

Locate well correctly on above Section Plat

Name of Conservation Agent who supervised plugging of this well Lee N. Guthrie

Producing formation _____ Depth to top _____ Bottom _____ Total Depth of Well 3165 Feet

Show depth and thickness of all water, oil and gas formations.

OIL, GAS OR WATER RECORDS

CASING RECORD

FORMATION	CONTENT	FROM	TO	SIZE	PUT IN	PULLED OUT
				8-5/8"	163'	none

Describe in detail the manner in which the well was plugged, indicating where the mud fluid was placed and the method or methods used in introducing it into the hole. If cement or other plugs were used, state the character of same and depth placed, from _____ feet to _____ feet for each plug set.

Filled with mud to 180', set plug, dumped 15 sacks cement, mud to 35', set plug, dumped 10 sacks cement, steel cap welded on surface, 3 sacks cement in rat hole.

RECEIVED
STATE CORPORATION COMMISSION
9-14-60
SEP 14 1960

CONSERVATION DIVISION

(If additional description is necessary, use BACK of this sheet)
Name of Plugging Contractor Stelbar Oil Corporation, Inc.
Address 310 Petroleum Bldg., Wichita, Kansas

STATE OF Kansas, COUNTY OF Sedgwick, ss.
Bertrand M. Lester, Jr. (employee of owner) ~~owner or operator~~ of the above-described

well, being first duly sworn on oath, says: That I have knowledge of the facts, statements, and matters herein contained and the log of the above-described well as filed and that the same are true and correct. So help me God.

(Signature) Bertrand M. Lester, Jr.

310 Petroleum Bldg. (Address)

SUBSCRIBED AND SWORN TO before me this 13 day of September, 1960



Leona Hargrove
Leona Hargrove, Notary Public.



LOG

Farm: Colburn
Well No. 1
SW SE NW 36-26S-3E
Butler County, Kansas

Owner: Stelbar Oil Corporation, Inc.
Contractor: Stelbar Oil Corporation, Inc.
Drilling Commenced: August 29, 1960
Drilling Completed: September 9, 1960

8-5/8" 163' cemented with 100 sacks

Elevation: 1342 DF 1340 GR

0	25	Surface Clay and Gravel
25	163	Broken Lime
163	335	Shale and Shells
335	450	Broken Lime
450	1885	Shale and Shells
1885	2064	Shale and Lime
2064	2452	Lime
2452	2529	Shale
2529	2759	Shale and Lime
2759	2929	Mississippi Lime
2929	2962	Lime
2962	3039	Lime and Shale
3039	3055	Viola
3055	3084	Simpson
3084	3135	Shale
3135	3165	Lime
	3165	RTD, D & A

RECEIVED

SEP 14 1960

CONSERVATION DIVISION
WICHITA, KANSAS

Mud to 180', set plug, dumped 15 sacks cement, mud to 35', set plug, dumped 10 sacks cement, steel cap welded on surface, 3 sacks cement in rat hole.