


STATE OF KANSAS
STATE CORPORATION COMMISSION
Give All Information Completely
Make Required Affidavit
Mail or Deliver Report to:
Conservation Division
State Corporation Commission
800 Bitting Building
Wichita, Kansas

WELL PLUGGING RECORD

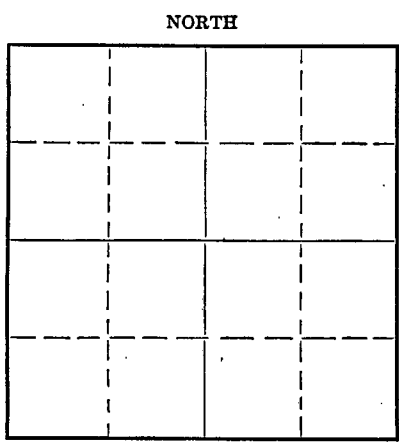

Butler County, Sec. 36 Twp. 26 Rge. 3 (E) (W)
 Location as "NE/CNW $\frac{1}{4}$ SW $\frac{1}{4}$ " or footage from lines SW SW SE
 Lease Owner The Bay Petroleum Corporation
 Lease Name Hazen Well No. 1
 Office Address Box 513, Chase Kansas
 Character of Well (completed as Oil, Gas or Dry Hole) Dry Hole
 Date well completed Nov. 2, 1951
 Application for plugging filed Written Nov. 26, 1951
 Application for plugging approved Oral - Nov. 2, 1951
 Plugging commenced Nov. 2, 1951
 Plugging completed Nov. 2, 1951
 Reason for abandonment of well or producing formation Dry Hole
 If a producing well is abandoned, date of last production 19
 Was permission obtained from the Conservation Division or its agents before plugging was commenced? Yes

Name of Conservation Agent who supervised plugging of this well
 Producing formation Arbuckle (test) Depth to top 3089 Bottom Total Depth of Well 3114 Feet
 Show depth and thickness of all water, oil and gas formations.

OIL, GAS OR WATER RECORDS

CASING RECORD

Formation	Content	From	To	Size	Put In	Pulled Out
				8 5/8"	365'	None

Describe in detail the manner in which the well was plugged, indicating where the mud fluid was placed and the method or methods used in introducing it into the hole. If cement or other plugs were used, state the character of same and depth placed, from feet to feet for each plug set.

Filled with heavy mud to 180'
 Set plug at 180' and cemented w/10 sax cement through drill pipe
 Filled with heavy mud to 20'
 Set plug at 20' and cemented with 5 sax cement

STATE CORPORATION COMMISSION
 11-29-51
 NOV 29 1951

(If additional description is necessary, use BACK of this sheet)
 Correspondence regarding this well should be addressed to The Bay Petroleum Corporation
 Address Box 513, Chase Kansas

STATE OF Kansas, COUNTY OF Rice, ss.
 Forrest Crawford (employee of owner) of the above-described well,

being first-duly sworn on oath, says: That I have knowledge of the facts, statements, and matters herein contained and the log of the above-described well as filed and that the same are true and correct. So help me God.

(Signature) *Forrest Crawford*
 (Address)

SUBSCRIBED AND SWORN to before me this 26 day of November 2, 1951

Cincere O Gray
 Notary Public.

My commission expires May 20, 1954

PLUGGING
 FILE SEC 36 R 36
 BOOK PAGE 182 LINE 9

WELL LOG BUREAU—KANSAS GEOLOGICAL SOCIETY

508 East Murdock,

Wichita, Kansas

Company- BAY PETRO. CORP.

Farm- Hazen

No. 11

SEC. 36 T. 26 R. 3E

SW SW SE

Total Depth. 3116

Comm. 10-14-51

Comp. 11-2-51


County Butler

KANSAS

Shot or Treated.

Contractor. Cappitt Drlg.

Issued. 11-24-51

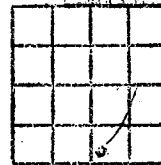

Elevation. 1328

Production. Dry

Figures Indicate Bottom of Formations.

surface clay	5
shells & shale	10
broken lime	100
shale & lime	530
shale & shells	675
shale & lime	1210
shale & shells	1385
lime & shale	1495
lime & shale brk	1545
lime & shale	1914
lime	1990
lime	2088
lime & shale	2270
lime	2465
shale & lime	2695
shale	2698
lime	2707
shale	2723
lime	2775
shale & lime	2793
chat	2812
lime	2839
lime & shale	2873
lime	2935
shale	2976
lime	2986
shale	2993
lime	3008
sand & shale	3071
shale	3083
sand	3087
shale	3091
lime	3116
Total Depth	

Tops: D.F.	
Lansing	1911
Kansas City	2267
Mississippi	2731
Viola	2880
Simpson	3009
Arbuckle	3089

DST: 2976-96' P 20"
rec. 1645' wtr. 1195# BHP.

Tops:	
Lansing	1914
Kansas City	2270
Miss.	2734
Viola	2998
Simpson sd.	3045

RECEIVED
NOV 29 1951
DIVISION
Wichita, Kansas

PLUGGING
FILE SEC 36 T 26 R 3E
BOOK PAGE 124 9