

STATE OF KANSAS
STATE CORPORATION COMMISSION


Give All Information Completely
Make Required Affidavit
Mail or Deliver Report to:
Conservation Division
State Corporation Commission
212 North Market, Insurance Bldg.
Wichita, Kansas

WELL PLUGGING RECORD

BUTLER

County Sec. 19 Twp. 26 Rge. 3 (E) (W)

NORTH

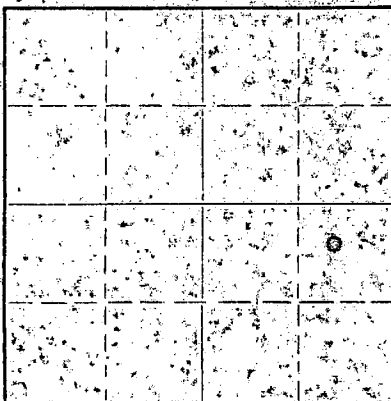

Locate well correctly on above
Section Plat

Location as "NE/CNW/SW" or footage from lines C NE SE
Lease Owner PETROLEUM INC.
Lease Name MANSPEAKER Well No. 1
Office Address 352 N. Broadway, Wichita, Kansas
Character of Well (completed as Oil, Gas or Dry Hole) Dry
Date well completed 7-21 19 60
Application for plugging filed 7-21 19 60
Application for plugging approved 7-21 19 60
Plugging commenced 7-21 19 60
Plugging completed 7-21 19 60
Reason for abandonment of well or producing formation Dry

If a producing well is abandoned, date of last production 19
Was permission obtained from the Conservation Division or its agents before plugging was commenced? Yes

Name of Conservation Agent who supervised plugging of this well Cecil E. Jones
Producing formation Depth to top Bottom Total Depth of Well 2865 Feet
Show depth and thickness of all water, oil and gas formations.

OIL, GAS OR WATER RECORDS

CASING RECORD

FORMATION	CONTENT	FROM	TO	SIZE	PUT IN	PULLED OUT

Describe in detail the manner in which the well was plugged, indicating where the mud fluid was placed and the method or methods used in introducing it into the hole. If cement or other plugs were used, state the character of same and depth placed, from feet to feet for each plug set.

Heavy mud to 180'
Set plug with 1/2 sack hullo - 15 sack cement
Heavy mud to 40'
Set plug with 1/2 sack hullo & 1/2 sack cement
Plugged rat hole with 25 sack cement

RECEIVED
STATE CORPORATION COMMISSION
7-26-60
JUL 26 1960

CONSERVATION DIVISION
WICHITA, KANSAS

(If additional description is necessary, use BACK of this sheet)
Name of Plugging Contractor Graves Drilling Company, Inc.
Address Box 332, El Dorado, Kansas

STATE OF KANSAS COUNTY OF BUTLER SS.
John C. Graves (employee of owner) or (owner or operator) of the above-described well, being first duly sworn on oath, says: That I have knowledge of the facts, statements, and matters herein contained and the log of the above-described well as filed and that the same are true and correct. So help me God.

(Signature) John C. Graves
Box 332, El Dorado, Kansas (Address)

SUBSCRIBED AND SWORN to before me this 22 day of July, 19 60

My commission expires Nov. 23, 1963 Marlene Fairchild Notary Public.

Total Depth - 2865' C-NE-SE
 Contractor - Graves Drilling Co., Inc Section 19--26-3E
 Commenced - 7-8-'60 Butler County, Kansas
 Completed - 7-11-'60 8 5/8" set @ 186'

FORMATION	DEPTH
Lime	186
Shale & Lime	480
Shale & Lime Strks	925
Shale	1100
Shale & Lime Strks	1120
Shale & Lime	2380
Lime (KC)	2468
Shale & Lime	2816
Miss. Chat	2830
Total Depth	2865

RECEIVED
 STATE CORPORATION COMMISSION
 JUL 26 1960
 CONSERVATION DIVISION
 Wichita, Kansas

I hereby certify the foregoing statements to be true and correct
 to the best of my knowledge.

GRAVES DRILLING COMPANY, INC.

By John C. Graves



STATE OF KANSAS)
) ss
 COUNTY OF BUTLER)

Subscribed and sworn to before me, a Notary Public, this 22 day of
July, 1960

My commission expires:

Nov. 23, 1963

Marlene Fairchild
 (Notary Public)