

RECEIVED  
09-29-2003  
SEP 29 2003

KCC WICHITA

KANSAS CORPORATION COMMISSION  
OIL & GAS CONSERVATION DIVISION  
WELL PLUGGING APPLICATION  
Please TYPE Form and File ONE Copy

Form CP-1  
September 2003  
This Form must be Typed  
Form must be Signed  
All blanks must be Filled

API # 15-065-20161-00-00 (Identifier Number of this well). This must be listed for wells drilled since 1967; if no API # was issued, indicate original spud or completion date August 2, 1968

Well Operator: Bowman Oil Company KCC License #: 6931  
(Owner / Company Name) (Operator's)

Address: 805 Codell Road City: Codell

State: Kansas Zip Code: 67663 Contact Phone: (785) 434-2286

Lease: Ziegler "C" Well #: 1 Sec. 16 Twp. 10 S. R. 21  East  West

SW - NW - SE Spot Location / QQQQ County: Graham

KCC 1485-1650 Feet (in exact footage) From  North /  South (from nearest outside section corner) Line of Section (Not Lease Line)  
KCC 4845-2310 Feet (in exact footage) From  East /  West (from nearest outside section corner) Line of Section (Not Lease Line)

Check One:  Oil Well  Gas Well  D&A  Cathodic  Water Supply Well  
 SWD Docket # \_\_\_\_\_  ENHR Docket # \_\_\_\_\_  Other: \_\_\_\_\_

Conductor Casing Size: \_\_\_\_\_ Set at: \_\_\_\_\_ Cemented with: \_\_\_\_\_ Sacks

Surface Casing Size: 8 5/8" Set at: 216 Cemented with: 185 Sacks

Production Casing Size: 4 1/2" Set at: 3809 Cemented with: 250 Sacks

List (ALL) Perforations and Bridgeplug Sets: \_\_\_\_\_

Elevation: 2198 ( G.L. /  K.B.) T.D.: 3810 PBTD: \_\_\_\_\_ Anhydrite Depth: \_\_\_\_\_  
(Stone Corral Formation)

Condition of Well:  Good  Poor  Casing Leak  Junk in Hole

Proposed Method of Plugging (attach a separate page if additional space is needed): will cement well according to KCC Dist # 4 instructions

Is Well Log attached to this application as required?  Yes  No Is ACO-1 filed?  Yes  No

If not explain why? \_\_\_\_\_

Plugging of this Well will be done in accordance with K.S.A. 55-101 et. seq. and the Rules and Regulations of the State Corporation Commission.

List Name of Company Representative authorized to be in charge of plugging operations: Louis D Bowman &/or Paul H Bowman

Phone: (785) 434-2286

Address: 805 Codell Road City / State: Codell, KS 67663

Plugging Contractor: Allied Cementing Inc KCC License #: \_\_\_\_\_  
(Company Name) (Contractor's)


Address: Russell, Kansas 67665 Phone: (785) 483-2627

Proposed Date and Hour of Plugging (if known?): October 1, 2003

Payment of the Plugging Fee (K.A.R. 82-3-118) will be guaranteed by Operator or Agent

Date: Sept 26, 2003 Authorized Operator / Agent: Jackie Langholz  
(Signature)

Mail to: KCC - Conservation Division, 130 S. Market - Room 2078, Wichita, Kansas 67202

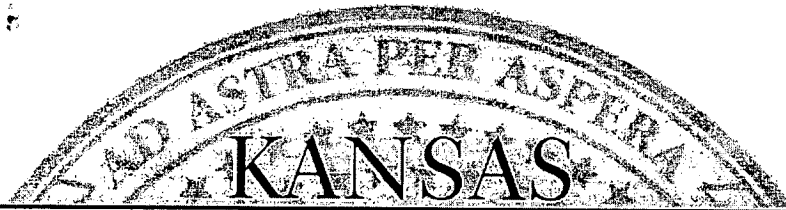

**NOTICE OF RECEIPT OF WELL PLUGGING APPLICATION (CP-1)**

Bowman Oil Company  
805 Codell Rd.  
Codell, KS 67663

October 01, 2003

Re: ZEIGLER C #1  
API 15-065-20161-00-00  
SWNWSE 16-10S-21W, 1485 FSL 1815 FEL  
GRAHAM COUNTY, KANSAS

Dear Operator:

This letter is to notify you that the Conservation Division is in receipt of your plugging proposal, form CP-1, for the above-captioned well.


Your CP-1 has been reviewed by the Conservation Division central office for completeness and to verify license numbers. The plugging proposal will now be forwarded to the district office listed below for review of your proposed method of plugging.

**Please contact the district office for approval of your proposed plugging method at least five (5) days before plugging the well, pursuant to K.A.R. 82-3-113 (b). If a workover pit will be used during the plugging of the well it must be permitted. A CDP-1 form must be filed and approved prior to the use of the pit.**

The Conservation Division's review of form CP-1, either in the central or district office, does not include an inquiry into well ownership or the filing operator's legal right to plug the well.


**This notice in no way constitutes authorization to plug the above-captioned well by persons not having legal rights of ownership or interest in the well. This notice is void after ninety (90) days from the above date.**

District: #4  
2301 E. 13th  
Hays, KS 67601  
(785) 625-0550

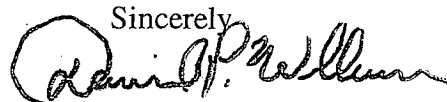Sincerely,  


David P. Williams  
Production Supervisor

15-065 - 20161-00-00

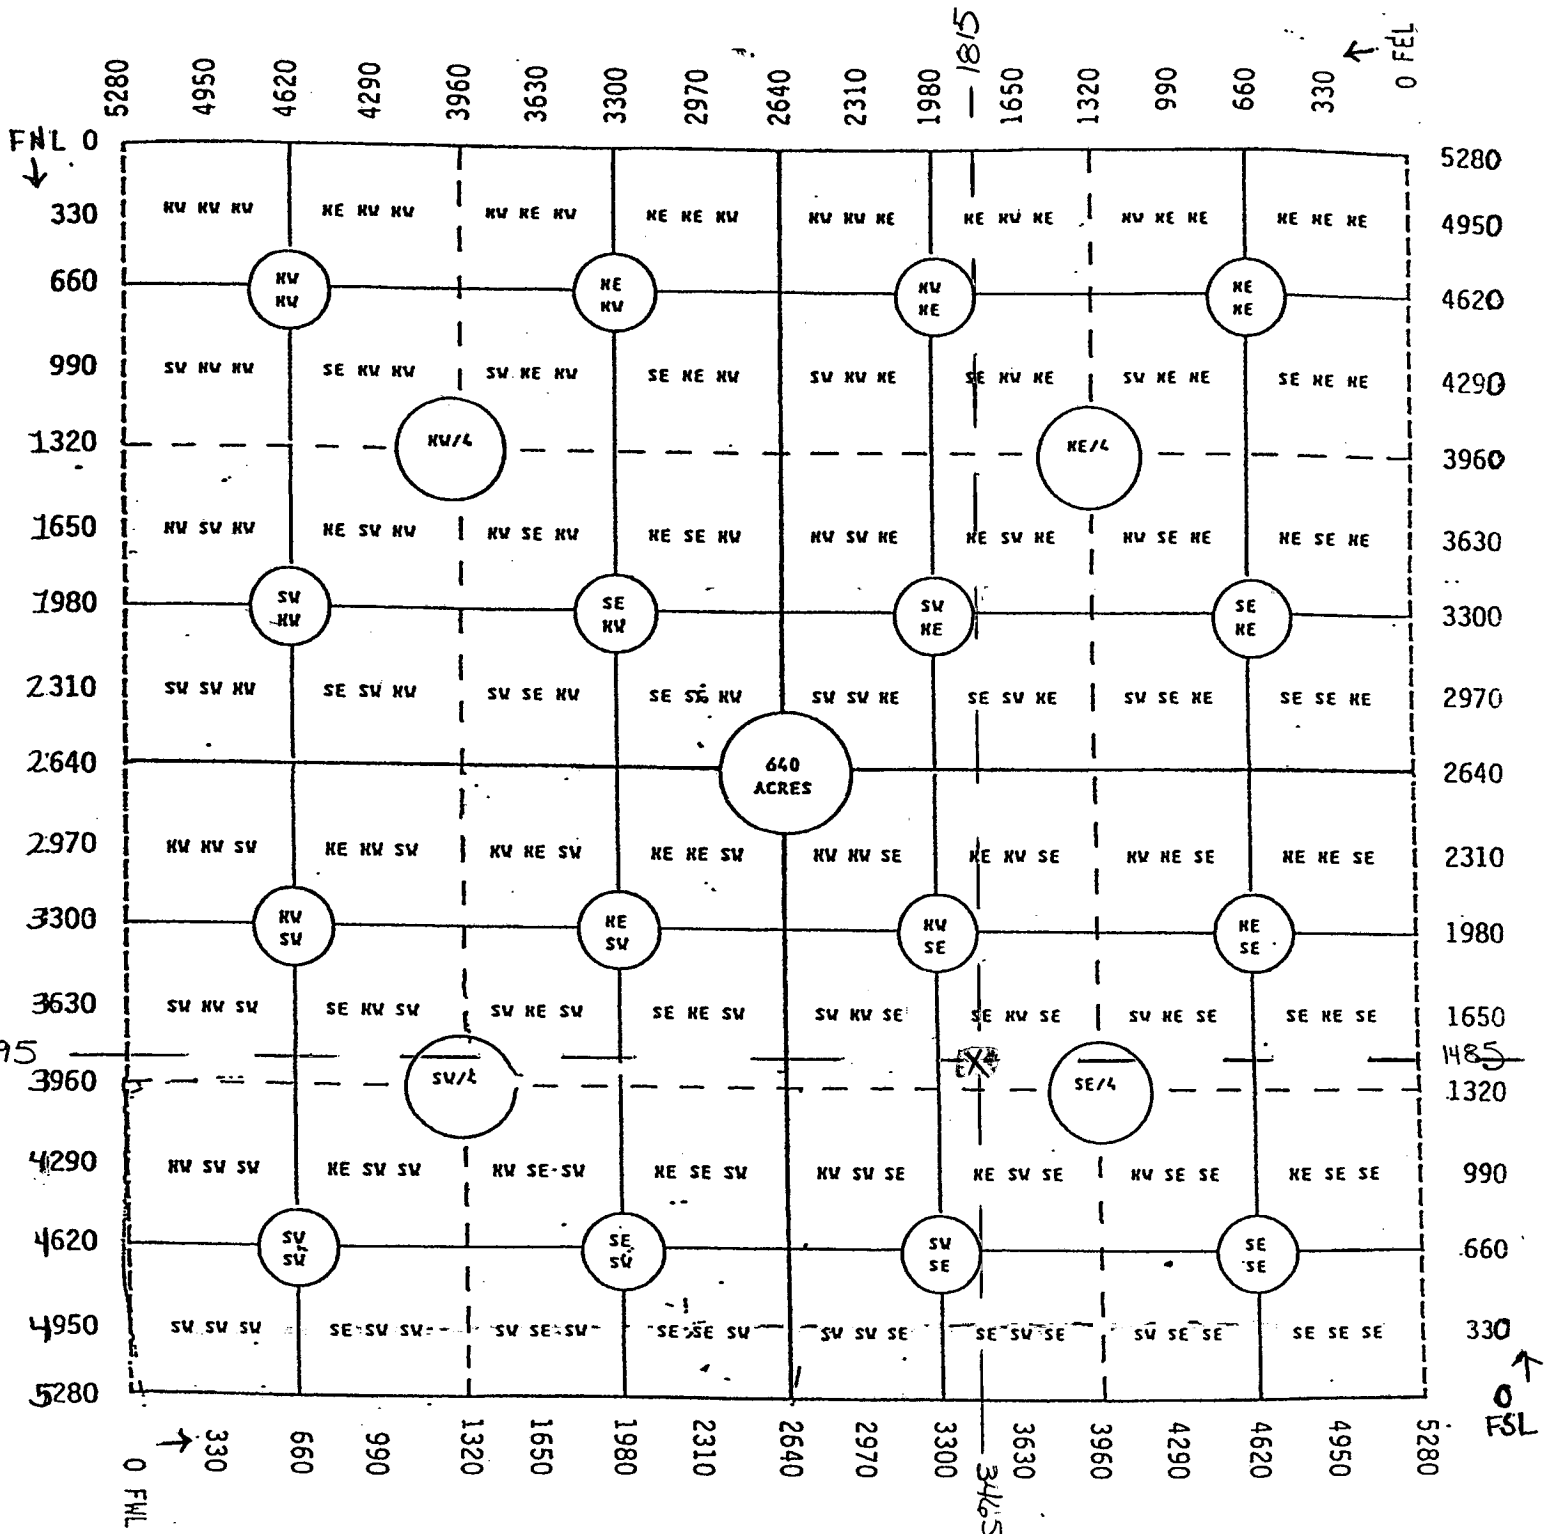

Zeigler "C" # 1

SW NW SE 16-10-21w Graham Co KS  
 1485 FSL  
 3795 FNL  
 3465 FWL  
 1815 FEL

RECEIVED  
 SEP 29 2003  
 KCC WICHITA