

CARD MUST BE TYPED

State of Kansas

CARD MUST BE SIGNED

NOTICE OF INTENTION TO DRILL

(see rules on reverse side)

Starting Date June 15, 1987
month day year 10.23

API Number 15- 163-22,931-00-00 ✓ TDA
NW SE SW Sec. 5 Twp. 10 S, Rg. 16 ~~East~~ X West
990 Ft. from South Line of Section
3630 Ft. from East Line of Section

OPERATOR: License # 5068
Name Black Petroleum Company
Address 527 Union Center Bldg.
City/State/Zip Wichita, Kansas 67202
Contact Person Thomas E. Black
Phone 316-264-9342

(Note: Locate well on Section Plat on reverse side)
Nearest lease or unit boundary line 330 feet
County Rooks
Lease Name COLLINS Well # 1

CONTRACTOR: License # 8241
Name Emphasis Oil Operations
City/State Russell, Kansas

Ground surface elevation 2012 feet MSL
Domestic well within 330 feet: ___yes X no
Municipal well within one mile: ___yes X no

Well Drilled For: Well Class: Type Equipment:
X Oil ___ SWD ___ Infield X Mud Rotary
___ Gas ___ Inj. X Pool Ext. ___ Air Rotary
___ OWWO ___ Expl ___ Wildcat ___ Cable

Depth to bottom of fresh water 55
Depth to bottom of usable water 70.0
Surface pipe by Alternate: 1 ___ 2 X

If OWWO: old well info as follows:

Surface pipe planned to be set 250
Conductor pipe required
Projected Total Depth 3540 feet
Formation Arbuckle

Operator
Well Name
Comp Date Old Total Depth

I certify that well will comply with K.S.A. 55-101, et seq., plus eventually plugging hole to KCC specifications.
Date 6/15/87 Signature of Operator or Agent Thomas E. Black Title Owner

For KCC Use:

Conductor Pipe Required feet; Minimum Surface Pipe Required 200 feet per Alt. 402
This Authorization Expires 12-15-87 Approved By 6-15-87


Handwritten signature and initials at bottom right.

Must be filed with the K.C.C. five (5) days prior to commencing well
This card void if drilling not started within six (6) months of date received by K.C.C.

Important procedures to follow:

1. Notify District office before setting surface casing.
2. Set surface casing by circulating cement to the top.
3. File completion forms ACO-1 with K.C.C. within 90 days of well completion, following instructions on ACO-1, side 1, and including copies of wireline logs.
4. Notify District office 48 hours prior to old well workover or re-entry.
5. Prior to filing Intent, prepare a proposed plugging plan in case well is D & A, then obtain approval of plan when calling district office prior to setting surface pipe.
6. Submit plugging report (CP-4) to K.C.C. after plugging is completed.
7. Obtain an approved injection docket number before disposing of salt water.
8. Notify K.C.C. within 10 days when injection commences or terminates.
9. If an alternate 2 completion, cement in the production pipe from below any usable water to surface within 120 days of spud date.

**A Regular Section of Land
1 Mile = 5,280 Ft.**

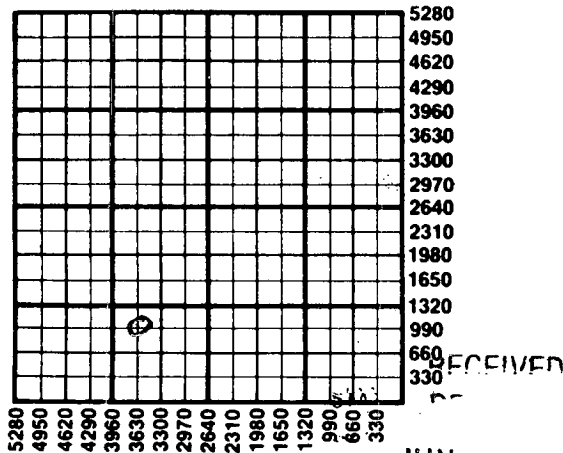

JUN 15 1987

CONSERVATION DIVISION
Wichita, Kansas

State Corporation Commission of Kansas
Conservation Division
200 Colorado Derby Building
Wichita, Kansas 67202
(316) 263-3238