

NOTICE OF INTENTION TO DRILL

(see rules on reverse side)

Starting Date 4-15-87 month day year

API Number 15-163-22,917-00-00

OPERATOR: License # 5011 Name Viking Resources Address 120 S. Market, Suite 518 City/State/Zip Wichita, KS 67202-3819 Contact Person Jim Devlin Phone (316) 262-2502

SW NE SW Sec 5 Twp 10 S, Rg 16 West 1650 Ft. from South Line of Section 3630 Ft. from East Line of Section

(Note: Locate well on Section Plat on reverse side)

CONTRACTOR: License # Name Unknown City/State

Nearest lease or unit boundary line 990 feet County Rooks Lease Name Collins Well # 1

Well Drilled For: Well Class: Type Equipment: Oil SWD Infield Mud Rotary Gas Inj Pool Ext Air Rotary OWWO Expl Wildcat Cable

Ground surface elevation Unknown feet MSL Domestic well within 330 feet: yes X no Municipal well within one mile: yes X no Depth to bottom of fresh water 65 Depth to bottom of usable water 750 Surface pipe by Alternate 1 2 X Surface pipe planned to be set 200 Conductor pipe required None Projected Total Depth 3550 feet Formation Arbuckle

If OWWO: old well info as follows:

Operator Well Name Comp Date Old Total Depth

I certify that well will comply with K.S.A. 55-101, et seq., plus eventually plugging hole to KCC specifications.

Date 30 March 1987 Signature of Operator or Agent James B. Devlin Title Operator

For KCC Use:

Conductor Pipe Required feet; Minimum Surface Pipe Required 200 feet per Alt. 4 2 This Authorization Expires 10-2-87 Approved By 4-1-87


Handwritten signature and initials at bottom right.

Must be filed with the K.C.C. five (5) days prior to commencing well
This card void if drilling not started within six (6) months of date received by K.C.C.

Important procedures to follow:

1. Notify District office before setting surface casing.
2. Set surface casing by circulating cement to the top.
3. File completion forms ACO-1 with K.C.C. within 90 days of well completion, following instructions on ACO-1, side 1, and including copies of wireline logs.
4. Notify District office 48 hours prior to old well workover or re-entry.
5. Prior to filing Intent, prepare a proposed plugging plan in case well is D & A, then obtain approval of plan when calling district office prior to setting surface pipe.
6. Submit plugging report (CP-4) to K.C.C. after plugging is completed.
7. Obtain an approved injection docket number before disposing of salt water.
8. Notify K.C.C. within 10 days when injection commences or terminates.
9. If an alternate 2 completion, cement in the production pipe from below any usable water to surface within 120 days of spud date.

A Regular Section of Land 1 Mile = 5,280 Ft.

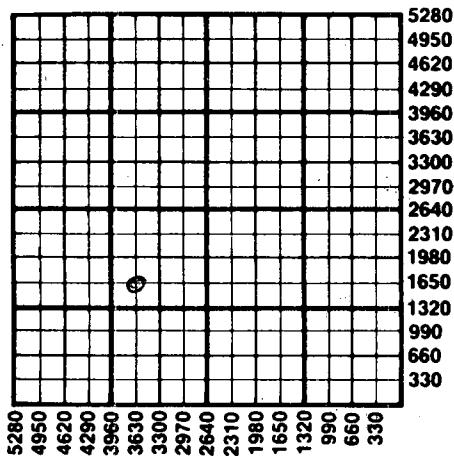

APR 1 1987
4-1-87

State Corporation Commission of Kansas
Conservation Division
200 Colorado Derby Building
Wichita, Kansas 67202
(316) 263-3238