


15-163-00492-00-00

WELL PLUGGING RECORD

Give All Information Completely  
Make Required Affidavit  
Mail or Deliver Report to:  
Conservation Division  
State Corporation Commission  
800 Bittling Building  
Wichita, Kansas

Rooks County, Sec. 1 Twp 10 Rge 17 (E) (W)  
Location as "NE/CNW 1/4 SW 1/4" or footage from lines C. NW 1/4  
Lease Owner The Derby Oil Company  
Lease Name Klim Well No. 1  
Office Address Box 1030, Wichita, Kansas  
Character of Well (completed as Oil, Gas or Dry Hole) Dry Hole  
Date well completed June 11, 1953  
Application for plugging filed June 23, 1953  
Application for plugging approved June 11, 1953  
Plugging commenced June 11, 1953  
Plugging completed June 11, 1953  
Reason for abandonment of well or producing formation Dry Hole

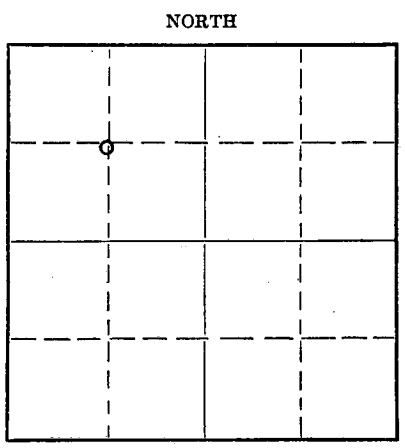

Locate well correctly on above Section Flat

If a producing well is abandoned, date of last production 19...  
Was permission obtained from the Conservation Division or its agents before plugging was commenced? Yes

Name of Conservation Agent who supervised plugging of this well  
Producing formation Depth to top Bottom Total Depth of Well 3563 Feet  
Show depth and thickness of all water, oil and gas formations.

OIL, GAS OR WATER RECORDS CASING RECORD

Formation	Content	From	To	Size	Put In	Pulled Out
				8 5/8	154	None

Describe in detail the manner in which the well was plugged, indicating where the mud fluid was placed and the method or methods used in introducing it into the hole. If cement or other plugs were used, state the character of same and depth placed, from feet to feet for each plug set.

Heavy Rotary Mud 3563 - 155 1/2  
Wooden Plug 155 1/2 - 155  
Cement - 15 sks 155 - 115  
Heavy Rotary Mud 115 - 40 1/2  
Wooden Plug 40 1/2 - 40  
Cement - 10 sks 40 - 9  
Cellar surface 9 - Surface

RECEIVED  
STATE CORPORATION COMMISSION  
JUN 25 1953  
CONSERVATION DIVISION  
Wichita, Kansas

625-53

Name of Plugging Contractor Anschutz Drilling Company  
Address 709 Union National Bank Bldg.  
Wichita, Kansas

STATE OF KANSAS, COUNTY OF SEDGWICK, ss.  
W. W. Clements (employee of owner) or (owner) of the above-described well,  
being first duly sworn on oath, says: That I have knowledge of the facts, statements, and matters herein contained and the log of the above-described well as filed and that the same are true and correct. So help me God.

(Signature) W. W. Clements  
Box 1030, Wichita, Kansas  
(Address)

SUBSCRIBED AND SWORN to before me this 23rd day of June, 1953

My commission expires August 24, 1953

H. A. Bilson  
Notary Public.

PLUGGING  
FILE SEC 1 T 10 R 17W  
BOOK PAGE 108 LINE 36

DRILLER'S LOG

The Derby Oil Company  
#1 Klim  
C NW/4 - 1-10S-17W  
Rooks County, Kansas

15-163-00492-00-00

FROM	TO	
0	160	Post rock & shale
160	500	Shale
500	800	Shale & sand streaks
800	890	Sand
890	1000	Shale
1000	1235	Red bed & shale
1235	1275	Anhydrite
1275	1709	Shale & shells
1709	2048	Lime & shale
2048	2950	Shale & shells
2950	3531	Lime
3531	3553	Cherty Conglomerate
3553	3563	Arbuckle
	3563	ROTARY TOTAL DEPTH
		D&A

COMMENCED: 5-31-53  
COMPLETED: 6-11-53

CASING RECORD

Set 8-5/8" surface casing at  
154' with 100 sacks cement.

STATE OF KANSAS )  
COUNTY OF SEDGWICK ) SS

I hereby affirm that the above and foregoing is a true and correct copy of the log of the #1 Klim located C NW/4 of Section 1-10S-17W, Rooks County, Kansas.

ANSCHUTZ DRILLING COMPANY

*Leon L. Mehler*  
BY: Leon L. Mehler

Subscribed and sworn to before me this 16th day of June, 1953.

*Jacqueline K...*  
Notary Public

My Commission Expires: May 2, 1956

STATE OF KANSAS  
COUNTY OF SEDGWICK

6-25-53

**PLUGGING**  
FILE SEC 1 T 10 R 17W  
BOOK PAGE 108 LINE 36