


15-163-02601-00-00

STATE OF KANSAS
STATE CORPORATION COMMISSION
Give All Information Completely
Make Required Affidavit
Mail or Deliver Report to:
Conservation Division
State Corporation Commission
211 No. Broadway
Wichita, Kansas

WELL PLUGGING RECORD

Rooks County. Sec. 23 Twp. 10 Rge. 16 (W) (W)
Location as "NE/CNW/SW" or footage from lines C NE NW NW
Lease Owner Cities Service Petroleum Company
Lease Name Matheson Well No. 1
Office Address Box 553, Russell, Kansas
Character of Well (completed as Oil, Gas or Dry Hole) Dry Hole
Date well completed 9-4-1962
Application for plugging filed 9-4-1962
Application for plugging approved 9-5-1962
Plugging commenced 9-5-1962
Plugging completed 9-5-1962
Reason for abandonment of well or producing formation Non Commercial

NORTH

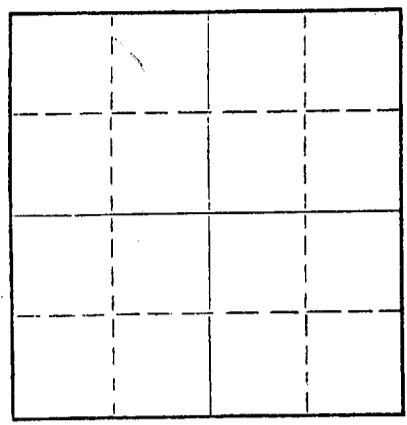

Locate well correctly on above Section Plat

If a producing well is abandoned, date of last production --- 19---
Was permission obtained from the Conservation Division or its agents before plugging was commenced? Yes

Name of Conservation Agent who supervised plugging of this well Eldon Petty
Producing formation _____ Depth to top _____ Bottom _____ Total Depth of Well 3668 Feet
Show depth and thickness of all water, oil and gas formations.

OIL, GAS OR WATER RECORDS

CASING RECORD

FORMATION	CONTENT	FROM	TO	SIZE	PUT IN	PULLED OUT
		0	240'	8-5/8"	240'	0

Describe in detail the manner in which the well was plugged, indicating where the mud fluid was placed and the method or methods used in introducing it into the hole. If cement or other plugs were used, state the character of same and depth placed, from _____ feet to _____ feet for each plug set.

Filled hole with heavy mud thru drill pipe 3668' to 550';
pushed Howco wooden plug to 550';
spotted 20 sx. cement thru drill pipe on plug at 550';
filled hole with heavy mud thru drill pipe to 220';
pushed Howco wooden plug and 1/4 sack hulls to 220';
spotted 20 sx. cement thru drill pipe on plug at 200';
filled hole with heavy mud thru drill pipe to 40';
pushed Howco wooden plug and 1/4 sack hulls to 40';
filled hole from 40' to surface (base of cellar) with
10 sx. cement - cut off 8-5/8" csg. at base of cellar
and capped w/cement - job complete at 3:00 P.M.

RECEIVED
STATE CORPORATION COMMISSION
11-16-1962
CONSERVATION DIVISION
Wichita, Kansas

(If additional description is necessary, use BACK of this sheet)


Name of Plugging Contractor Peel Brothers, Inc.
Address Hoisington, Kansas

STATE OF KANSAS, COUNTY OF RUSSELL, ss.
M. M. Hardin (employee of owner) or (owner or operator) of the above-described well, being first duly sworn on oath, says: That I have knowledge of the facts, statements, and matters herein contained and the log of the above-described well as filed and that the same are true and correct. So help me God.

(Signature) M. M. Hardin
M. M. Hardin, District Superintendent
Box 553, Russell, Kansas (Address)

SUBSCRIBED AND SWORN to before me this 7th day of Sept., 1962

My commission expires March 17, 1963

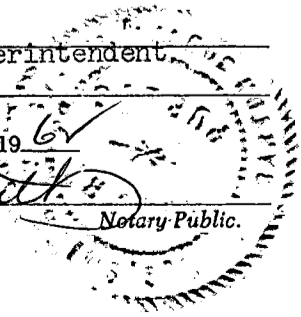

WELL RECORD

Company Cities Service Petroleum Co. Well No. 1 Farm Matheson
 Location 330° South and 990° East of NW Corner Sec. 23 T. 10 R. 16W
 Elevation 2086 KB, 2084 DF, County _____ Rocks _____ State Kansas
2079 Gr.
 Initial Prod. Dry hole; P&A 9-5-62. Contractor Peel Bros., Inc.
 Acid None Drig. Comm. 8-21-62
 T.D. 3668' Drig. Comp. 9-4-62

Casing Record:

8-5/8" at 238' with 200 sacks cement.

Formation Record:

lime	0-40
shale and lime	60
sand	155
shale and lime	480
sand and shale	515
sand	530
sand, shale and red beds	1190
shale	1282
anhydrite	1318
shale and lime	1915
lime	2020
lime and shale	2245
lime	2790
shale and lime	2885
lime and shale	2985
lime	3540
lime and shale	3615
lime	3625
lime, shale and chert	3660
cherty lime	3668 T.D.

Slope Tests (Syfo):

500'	- 1/2"
1000'	- 1/2"
2000'	- 1/2"
2555'	- 1/2"
3020'	- 1/2"

RECEIVED
 STATE CORPORATION COMMISSION

NOV. 16 1962
 11-16-1962
 CONSERVATION DIVISION
 Wichita, Kansas