

STATE CORPORATION COMMISSION OF KANSAS
OIL & GAS CONSERVATION DIVISION
WELL COMPLETION OR RECOMPLETION FORM
ACO-1 WELL HISTORY
DESCRIPTION OF WELL AND LEASE

Operator: License # 6066
Name Skyline Petroleum
Address P. O. Box 70
City/State/Zip Hays, KS 67601

Purchaser Koch Oil Company
Wichita, KS

Operator Contact Person Dan Schippers
Phone 913 625-0020

Contractor: License # 5145
Name Dreiling Oil, Inc.

Wellsite Geologist Jerry Green
Phone (913) 625-5155

Designate Type of Completion
 New Well Re-Entry Workover
 Oil SWD Temp Abd
 Gas Inj Delayed Comp.
 Dry Other (Core, Water Supply etc.)

If ONWO: old well info as follows:
Operator
Well Name
Comp. Date
Old Total Depth

WELL HISTORY

Drilling Method:
 Mud Rotary Air Rotary Cable
11-2-85 11-8-85 11-09-85
Spud Date Date Reached TD Completion Date
4100' R.T.D. 4075'
Total Depth PBTD

Amount of Surface Pipe Set and Cemented at 259 feet
Multiple Stage Cementing Collar Used? Yes No
If yes, show depth set 2284 feet
If alternate 2 completion, cement circulated from 2282 feet depth to Surface 450 SX cmt
Cement Company Name Allied Cementing Company
Invoice # 45155

API NO. 15-179-20.852-00-00
County Sheridan
SE NE NW Sec 32 Twp 9 Rge 26 East West

4290 Ft North from Southeast Corner of Section
2970 Ft West from Southeast Corner of Section
(Note: Locate well in section plat below)


Lease Name Minium Well # 1

Field Name Wildcat SKY

Producing Formation Lansing-K.C.

Elevation: Ground 2647' KB 2652'

Section Plat

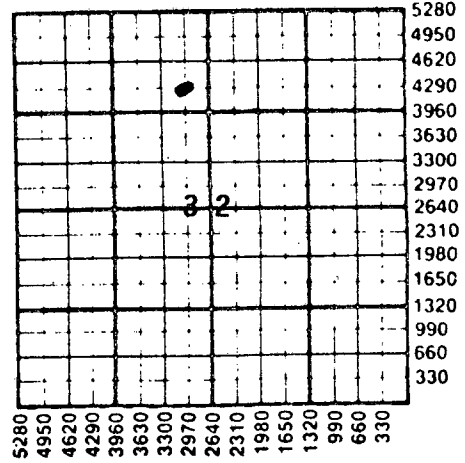

WATER SUPPLY INFORMATION

Disposition of Produced Water: Disposal Repressuring
Docket #

Questions on this portion of the ACO-1 call:

Water Resources Board (913) 296-3717
Source of Water:
Division of Water Resources Permit # T85-946
 Groundwater 4390 Ft North from Southeast Corner
(Well) 2870 Ft West from Southeast Corner of
Sec 32 Twp 9S Rge 26 East West
Surface Water Ft North from Southeast Corner
(Stream, pond etc) Ft West from Southeast Corner
Sec Twp Rge East West
Inc Other (explain)
(purchased from city, R.W.D. #)

INSTRUCTIONS: This form shall be completed in duplicate and filed with the Kansas Corporation Commission, 200 Colorado Derby Building, Wichita, Kansas 67202, within 90 days after completion or recompletion of any well. Rule 82-3-130 and 82-3-107 apply.

Information on side two of this form will be held confidential for a period of 12 months if requested in writing and submitted with the form. See rule 82-3-107 for confidentiality in excess of 12 months. One copy of all wireline logs and drillers time log shall be attached with this form. Submit CP-4 form with all plugged wells. Submit CP-111 form with all temporarily abandoned wells.

All requirements of the statutes, rules and regulations promulgated to regulate the oil and gas industry have been fully complied with and the statements herein are complete and correct to the best of my knowledge.

Signature Daniel F. Schaefer
Title Manager Date 1-16-86

Subscribed and sworn to before me this 16th day of January 1986
Notary Public Darlene Pearson

Date Commission Expires 7-10-89
NOTARY PUBLIC - State of Kansas
DARLENE PEARSON
My Appt. Exp. July 10, 1989

NOTARY PUBLIC - State of Kansas
DARLENE PEARSON
My Appt. Exp. July 10, 1989

K.C.C. OFFICE USE ONLY
 Letter of Confidentiality Attached
 Wireline Log Received
 Drillers Timelog Received
Distribution
 KCC SWD/Rep NGPA
 KGS Plug Other
(Specify)
RECEIVED
STATE CORPORATION COMMISSION
Form ACO-1 (7-84)

JAN 17 1986
01-17-1986
CONSERVATION DIVISION
Wichita, Kansas

Sec 32 Twp 9 Rge 26 E