

CARD MUST BE TYPED

State of Kansas  
**NOTICE OF INTENTION TO DRILL**  
(see rules on reverse side)

CARD MUST BE SIGNED

Starting Date: September 25, 1984  
month day year *11.04*

API Number 15- 065-22,075-0000

**OPERATOR:** License # 5068  
Name Thomas E. Black d/b/a Black Petroleum Co.  
Address 527 Union Center Bldg.  
City/State/Zip Wichita, Kansas 67202  
Contact Person Thomas E. Black  
Phone 264-9342

100' W. of N/2N/2 SE/4 26. Twp 10. S, Rge 23. Sec 26  
(location)

East  
 West

2310..... Ft North from Southeast Corner of Section  
1420..... Ft West from Southeast Corner of Section  
(Note: Locate well on Section Plat on reverse side)

**CONTRACTOR:** License # 5110  
Name B & B Drilling, Inc.  
City/State Wichita, Kansas

Nearest lease or unit boundary line 330 feet.  
County Graham  
Lease Name KLENK B Well# 1

**Well Drilled For:**      **Well Class:**      **Type Equipment:**  
 Oil       Swd       Infield       Mud Rotary  
 Gas       Inj       Pool Ext.       Air Rotary  
 OWWO       Expl       Wildcat       Cable

Domestic well within 330 feet:       yes       no  
Municipal well within one mile:       yes       no

If OWWO: old well info as follows:

Operator .....  
Well Name .....  
Comp Date ..... Old Total Depth .....  
Projected Total Depth 3825 feet  
Projected Formation at TD Base Kansas City  
Expected Producing Formations Lansing Kansas City

Depth to Bottom of fresh water 160 feet  
Lowest usable water formation Dakota  
Depth to Bottom of usable water 1000 feet  
Surface pipe by Alternate:      1       2   
Surface pipe to be set 250 feet  
Conductor pipe if any required ..... feet  
Ground surface elevation ..... feet MSL  
This Authorization Expires 3-21-85  
Approved By 9-21-84 *RE*

I certify that we will comply with K.S.A. 55-101, et seq., plus eventually plugging hole to K.C.C. specifications.

Date 9-21-84 Signature of Operator or Agent Thomas E. Black Title Owner


*m HC/KONE 9/21/84*  
Form C-1 4/84

CONSERVATION DIVISION  
WICHITA, KANSAS

Must be filed with the K.C.C. five (5) days prior to commencing well  
This card void if drilling not started within six (6) months of date received by K.C.C.

SEP 21 1984

A Regular Section of Land  
1 Mile = 5,280 Ft.

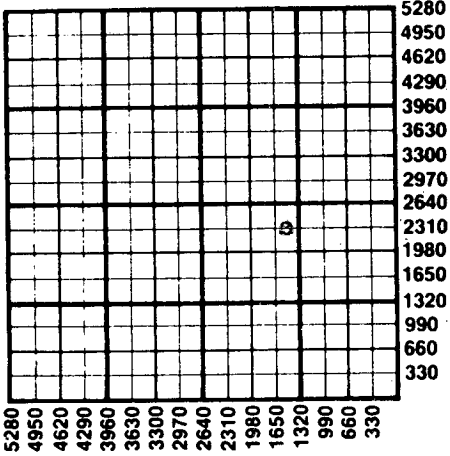

Important procedures to follow :

1. Notify District office before setting surface casing.
2. Set surface casing by circulating cement to the top.
3. File completion forms ACO-1 with K.C.C. within 90 days of well completion, following instructions on ACO-1, side 1, and including copies of wireline logs.
4. Notify District office 48 hours prior to old well workover or re-entry.
5. Prior to plugging, prepare a plugging plan, then obtain agreement from the appropriate district office for an approved plugging plan.
6. Submit plugging report (CP-4) to K.C.C. after plugging is completed.
7. Obtain an approved injection docket number before disposing of salt water.
8. Notify K.C.C. within 10 days when injection commences or terminates.
9. If an alternate 2 completion, cement in the production pipe from below any usable water to surface within 120 days of spud date.

State Corporation Commission of Kansas  
Conservation Division  
200 Colorado Derby Building  
Wichita, Kansas 67202  
(316) 263-3238