

Notice: Fill out COMPLETELY and return to Conservation Division at the address below within 60 days from plugging date.

KANSAS CORPORATION COMMISSION  
OIL & GAS CONSERVATION DIVISION  
**WELL PLUGGING RECORD**  
K.A.R. 82-3-117

Form CP-4  
December 2003  
Type or Print on this Form  
Form must be Signed  
All blanks must be Filled

Lease Operator: Brungardt Oil & Leasing, Inc.  
Address: PO Box 871, Russell, KS 67665  
Phone: (785) 483-4975 Operator License #: 3956  
Type of Well: D & A Docket #: \_\_\_\_\_  
(Oil, Gas D&A, SWD, ENHR, Water Supply Well, Cathodic, Other) (If SWD or ENHR)  
The plugging proposal was approved on: 7-15-2008 (Date)  
by: Bruce Basye (KCC District Agent's Name)  
Is ACO-1 filed?  Yes  No If not, is well log attached?  Yes  No  
Producing Formation(s): List All (If needed attach another sheet)  
\_\_\_\_\_  
Depth to Top: \_\_\_\_\_ Bottom: \_\_\_\_\_ T.D. \_\_\_\_\_  
\_\_\_\_\_  
Depth to Top: \_\_\_\_\_ Bottom: \_\_\_\_\_ T.D. \_\_\_\_\_  
\_\_\_\_\_  
Depth to Top: \_\_\_\_\_ Bottom: \_\_\_\_\_ T.D. \_\_\_\_\_

API Number: 15-163-23,744-00-00  
Lease Name: Bigge B - Riffe Pool  
Well Number: 1  
Spot Location (QQQQ): \_\_\_\_\_ - NE - NE - NW  
460 Feet from  North /  South Section Line  
2,400 Feet from  East /  West Section Line  
Sec. 29 Twp. 6 S. R. 18  East  West  
County: Rooks  
Date Well Completed: 7-15-08  
Plugging Commenced: 7-15-08  
Plugging Completed: 7-15-08

Show depth and thickness of all water, oil and gas formations.

Oil, Gas or Water Records		Casing Record (Surface Conductor & Production)				
Formation	Content	From	To	Size	Put In	Pulled Out
				8 5/8"	219'	Cmtd. w/160 sax


Describe in detail the manner in which the well is plugged, indicating where the mud fluid was placed and the method or methods used in introducing it into the hole. If cement or other plugs were used, state the character of same depth placed from (bottom), to (top) for each plug set.  
Run drill pipe to 1,620', pump 25 sax cement thru drill pipe; run drill pipe to 970', pump 100 sax cement thru drill pipe; run drill pipe to 270', pump 40 sax cement thru drill pipe; push wiper plug to 40', dump 10 sax cement on plug to cellar. Circulate 15 sax cement down rat hole and 10 sax cement down mouse hole.

Name of Plugging Contractor: Shields Drilling Co. Oil Produces Inc License #: 5184  
Address: PO Box 709, Russell, KS 67665  
Name of Party Responsible for Plugging Fees: Brungardt Oil & Leasing, Inc.  
State of KANSAS County, RUSSELL, ss.

RECEIVED  
KANSAS CORPORATION COMMISSION  
JUL 31 2008

Burton Beery Contractor  
(Employee of Operator or Operator) on above-described well, being first duly sworn on oath, says: That I have knowledge of the facts statements, and matters herein contained, and the log of the above-described well is as filed, and the same are true and correct, so help me God.  
(Signature) Burton Beery  
(Address) PO Box 709, Russell, KS 67665

SUBSCRIBED and SWORN TO before me this 29th day of July, 2008  
Ruth Phillips Notary Public My Commission Expires: \_\_\_\_\_

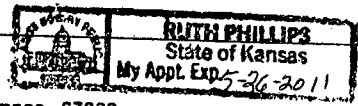




# Shields

Russell, Kansas

## WELL LOG

Operator: Brungardt Oil & Leasing, Inc.  
 Well: Bigge B - Riffe Pool #1  
 Commenced: July 7, 2008  
 Completed: July 15, 2008  
 Contractor: Shields Drilling Co.

Well Description: 460' FNL, 2,400' FWL  
 NW/4 Sec. 29-6S-18W  
 Rooks Co., KS

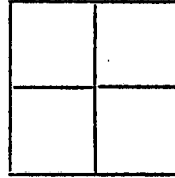

### CASING RECORD

Size	Run	Pulled
8 5/8"	219'	Cmtd. w/160 sax

Elevation: 2,073'

Treatment:

Production: D & A

Tops:

..... Figures Indicate Bottom of Formations .....

Sand & shale	895'
Sand	1,305'
Sand & redbed	1,604'
Anhydrite	1,634'
Redbed & shale	2,050'
Shale	2,560'
Shale & lime	3,060'
Lime	3,535'
Conglomerate	3,630' RTD

RECEIVED  
 KANSAS CORPORATION COMMISSION

JUL 31 2008

CONSERVATION DIVISION  
 WICHITA, KS

Notes