


STATE OF KANSAS
STATE CORPORATION COMMISSION

WELL PLUGGING RECORD

Give All Information Completely
Make Required Affidavit
Mail or Deliver Report to
Conservation Division
State Corporation Comm.
245 North Water
Wichita, KS 67202

Butler County. Sec. 3 Twp. 26 Rge. 3E E/W
Location as "NE/CNW $\frac{1}{4}$ SW $\frac{1}{4}$ " or footage from lines _____
SW SW SW
Lease Owner Charles Carlock
Lease Name Larabee Well No. I
Office Address 1515 Hillcrest Newton, Kansas 67114
Character of Well (Completed as Oil, Gas or Dry Hole) Oil

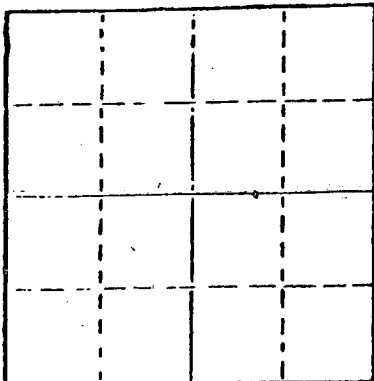

Locate well correctly on above
Section Plat

Date Well completed 5-30 1963
Application for plugging filed 8-3 1978
Application for plugging approved 8-4 1978
Plugging commenced 8-7 1978
Plugging completed 8-8 1978
Reason for abandonment of well or producing formation _____

If a producing well is abandoned, date of last production _____
19 _____

Was permission obtained from the Conservation Division or
its agents before plugging was commenced? yes

Name of Conservation Agent who supervised plugging of this well Wm. Thompson
Producing formation _____ Depth to top _____ Bottom _____ Total Depth of Well 2805'
Show depth and thickness of all water, oil and gas formations.

OIL, GAS OR WATER RECORDS

CASING RECORD

FORMATION	CONTENT	FROM	TO	SIZE	PUT IN	PULLED OUT
				5 1/2"		2,396'

Describe in detail the manner in which the well was plugged, indicating where the mud fluid was placed and the method or methods used in introducing it into the hold. If cement or other plugs were used, state the character of same and depth placed, from _____ feet to _____ feet for each plug set. Plugged off bottom of hole with sand. Sand from 2805' to 2700' Dumped 5 sx of cement. Mudded hole to 170'. Made 10' of rock bridge. Dumped 3 Yrds. of Ready-Mix Cement, filling to the bottom of the cellar.

RECEIVED
STATE CORPORATION COMMISSION
8-10-78
AUG 10 1978
CONSERVATION DIVISION
Wichita, Kansas

(If additional description is necessary, use BACK of this sheet)

Name of Plugging Contractor Art Lamb Casing Pulling Inc.
2809 King St. Hutchinson, Kansas 67501

STATE OF Kansas COUNTY OF Reno, ss.
Art Lamb (employee of owner) or (owner or operator)
of the above-described well, being first duly sworn on oath, says: That I have knowledge of the facts, statements, and matters herein contained and the log of the above-described well as filed and that the same are true and correct. So help me God.

(Signature) Art Lamb
2809 King St. Hutchinson, Kans. 67501
(Address)

SUBSCRIBED AND SWORN TO before me this 7th day of August, 1978

Judy Lamb
Notary Public.

My commission expires April 18, 1982



WELL LOG BUREAU—KANSAS GEOLOGICAL SOCIETY
508 East Murdock, Wichita, Kansas


Company- GEORGE R. HESS
Farm- Larabee No. 1

SEC. 3 T. 26 R. 3E
SW SW SW

Total Depth. 2752'
Comm. 5-24-63 Comp. 5-30-63
Shot or Treated.
Contractor. Blackstone Drlg., Inc.
Issued. 7-13-63

County Butler

KANSAS

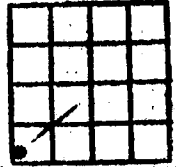

Elevation. 1310' ~~KS~~

CASINO:
8 5/8" 135' oem w/75 sxs.

Production. Dry

Figures Indicate Bottom of Formations.

rock & shale	135
lime	480
shale & lime	700
shale	1020
shale & lime	1380
lime & shale	1590
lime	1700
lime & shale	1760
shale & sand	1921
lime & shale	1970
lime	2000
lime & shale	2130
shale & lime	2300
lime & shale	2315
lime	2445
shale w/s lime	2585
lime & shale	2719
chert & lime	2752
Total Depth	

TOPS:	
Brown Lime	1921
Lansing	1970
Kansas City	2293
Conglomerate	2708
Mississippi	2719

Meas. taken from K.B.

RECEIVED
STATE CORPORATION COMMISSION
AUG 04 1978
CONSERVATION DIVISION
Wichita, Kansas

SE RO BEE DRLG OWWO
9-22-66 *wait SW SW SW

CO DD 2805' 5" 2903' w/ 60 sxs. PF 8/2747-54'. SWB DN NATL. PF
2737-42' SWB DN PF 2750-52,

SWB DN, POP FMP, 20 BOPD. TR. WTR.

2809 Lansing
Hutchinson 6750'