


STATE OF KANSAS
STATE CORPORATION COMMISSION

WELL PLUGGING RECORD

Give All Information Completely
Make Required Affidavit
Mail or Deliver Report to
Conservation Division
State Corporation Comm.
245 North Water
Wichita, KS 67202

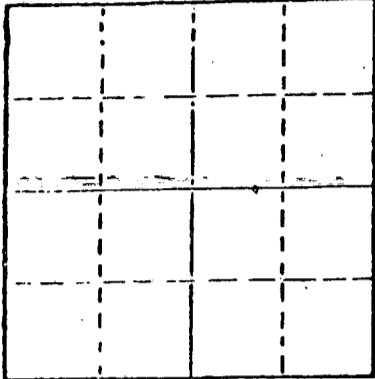

Locate well correctly on above
Section Plot

Butler County. Sec. 3 Twp. 26 Rge. 3 E E/W
Location as "NE/CNW $\frac{1}{4}$ SW $\frac{1}{4}$ " or footage from lines
SE SW SW

Lease Owner Charles Carlock
Lease Name Wait Well No. 3
Office Address 1515 Hillcrest Newton, Kansas 67114
Character of Well (Completed as Oil, Gas or Dry Hole) SWD

Date Well completed II-7 1966
Application for plugging filed 8-10 1978
Application for plugging approved 8-II 1978
Plugging commenced 8-14 1978
Plugging completed 8-16 1978
Reason for abandonment of well or producing formation

If a producing well is abandoned, date of last production 19

Was permission obtained from the Conservation Division or its agents before plugging was commenced? yes

Name of Conservation Agent who supervised plugging of this well Don Thompson
Producing formation Depth to top Bottom Total Depth of Well 2800'
Show depth and thickness of all water, oil and gas formations.

OIL, GAS OR WATER RECORDS

CASING RECORD

FORMATION	CONTENT	FROM	TO	SIZE	PUT IN	PULLED OUT
				5 1/2"		1732'

Describe in detail the manner in which the well was plugged, indicating where the mud fluid was placed and the method or methods used in introducing it into the hole. If cement or other plugs were used, state the character of same and depth placed, from feet to feet for each plug set. Plugged off bottom of hole with sand. Sand from 2800' to 2770'. Dumped 5 sx cement. Mudded hole to 230'. Made 15' of rock bridge. Dumped 3 Yrds of Ready-Mix Cement, filling to the bottom of the cellar.

RECEIVED
STATE CORPORATION COMMISSION

AUG 18 1978
8-18-78

CONSERVATION DIVISION
Wichita, Kansas

(If additional description is necessary, use BACK of this sheet)

Name of Plugging Contractor Art Lamb Casing Pulling Inc
2809 King St. Hutchinson, Kansas 67501

STATE OF Kansas COUNTY OF Reno, ss.
Art Lamb (employee of owner) or (owner or operator)
of the above-described well, being first duly sworn on oath, says: That I have knowledge of the facts, statements, and matters herein contained and the log of the above-described well as filed and that the same are true and correct. So help me God.

(Signature) Art Lamb
2809 King St. Hutchinson, Kansas
(Address)

SUBSCRIBED AND SWORN TO before me this 17th day of August, 1978

Judy Lamb
Notary Public.

My commission expires April 18, 1982



STENCILED

KANSAS GEOLOGICAL SOCIETY
KANSAS WELL LOG BUREAU - KANSAS WELL SAMPLE BUREAU
KANSAS GEOLOGICAL SOCIETY BUILDING
508 EAST MUROCK - WICHITA, KANSAS

ORIGINAL

DEC 31 1966
COMPANY

SeRobee Drilling Co., Inc.

SEC. 3 T. 26 N. 3E
LOC. SE SW SW

FARM Walt

NO. 8

COUNTY Butler


TOTAL DEPTH 2800'
COMM. 11-1-66

COMP. 11-7-66

SHOT OR TREATED

CONTRACTOR SeRobee Drilling Co., Inc.

ISSUED 12-31-66

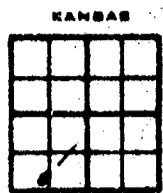

CASING
20 10
15 a 5/8 - W/200 sx
12 6
13 5 1/2 - W/100 sx

ELEVATION 1912 KB

PRODUCTION SWDW Rate Gals
(Miss 2753-2800)

FIGURES INDICATE BOTTOM OF FORMATIONS

0 - 190	Shale & Lime
190 - 425	Lime
425 - 700	Shale & Lime
700 - 1150	Shale & Lime Shells
1150 - 2255	Shale & Lime
2255 - 2475	Lime
2475 - 2710	Shale & Lime
2710 - 2753	Miss. Lime
2753 - 2756	Miss. Chert
2756 - 2800	Miss. Lime

GEOLOGICAL TOPS: SMP

K. C.	2267	(-955)
Base K/C	2433	(-1120)
Cherokee	2654	(-1342)
Miss.	2726	(-1414)
T. D.	2800	(-1488)

I Certify the above to be a true and correct copy of the driller's log and Geological Tops to the best of my knowledge and belief.

Paul S. Septer

Paul S. Septer

RECEIVED
STATE CORPORATION COMMISSION

AUG 11 1978

CONSERVATION DIVISION
Wichita, Kansas