

STATE OF KANSAS
STATE CORPORATION COMMISSION


WELL PLUGGING RECORD

Give All Information Completely
Make Required Affidavit
Mail or Deliver Report to
Conservation Division
State Corporation Comm.
245 North Water
Wichita, KS 67202

Butler County. Sec. 4 Twp. 26S Rge. 3E E/W
Location as "NE/CNW/SW" or footage from lines

C-NW-NE
Lease Owner Dunbar & Sons Oil Enterprises, INC
Lease Name Riley Well No. 1
Office Address RR #3 Box 252A Winfield, KS. 67156
Character of Well (Completed as Oil, Gas or Dry Hole)

Oil
Date Well completed 4-1 1979
Application for plugging filed 19
Application for plugging approved 7-11 1979
Plugging commenced 1979
Plugging completed 8-23 1979
Reason for abandonment of well or producing formation 8-24

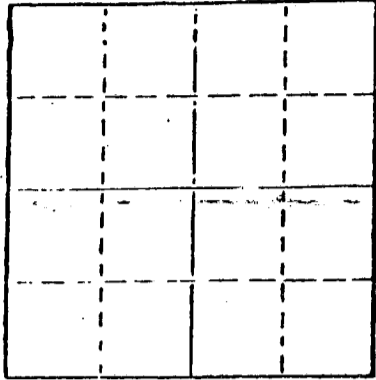

Locate well correctly on above Section Plat

If a producing well is abandoned, date of last production 19

Was permission obtained from the Conservation Division or its agents before plugging was commenced? yes

Name of Conservation Agent who supervised plugging of this well Don Thompson
Producing formation Depth to top 2276' Bottom 2279' Total Depth of Well 2733'
Show depth and thickness of all water, oil and gas formations.

OIL, GAS OR WATER RECORDS

CASING RECORD

FORMATION	CONTENT	FROM	TO	SIZE	PUT IN	PULLED OUT
				8 3/8"	200'	- 0 -
				4 1/2"	2727'	1823.95'

Describe in detail the manner in which the well was plugged, indicating where the mud fluid was placed and the method or methods used in introducing it into the hold. If cement or other plugs were used, state the character of same and depth placed, from feet to feet for each plug set. 8-23-79 Rigged up unit, Floor, Jacks. 8-24-79

Set Bottom Plug at 2250' with 10' rock bridge 5 sacks of Cement.
Ripped pipe at 1823' pulled pipe out. Set top plug at 215' with a 10' rock bridge. Filled to top with ready mix.

RECEIVED
STATE CORPORATION COMMISSION

AUG 30 1979
8-30-79

(If additional description is necessary, use BACK of this sheet)


Name of Plugging Contractor Towanda Well Service INC.

STATE OF KANSAS COUNTY OF Butler, ss.
George Keith (employee of owner) or (owner or operator)
of the above-described well, being first duly sworn on oath, says: That I have knowledge of the facts, statements, and matters herein contained and the log of the above-described well as filed and that the same are true and correct. So help me God.

(Signature) Lewis P. Wilson
608 Main, Towanda, KS. 67144
(Address)

SWORN TO before me this 27th day of August, 1979

Robert L. Simmons
Notary Public.

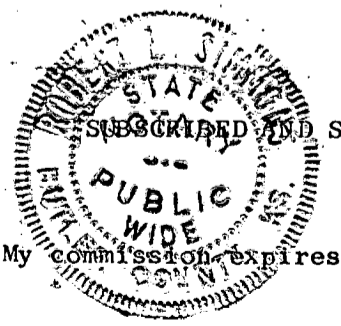

My commission expires July 17-1980

DUNBAR DRILLING INC.

5252 NORTH BROADWAY

WICHITA, KANSAS 67219

(316) 882-0501

COMPANY DUNBAR & SON ENTERPRISES, INC.
FARM Riley
WELL No. 1
LOCATION C NW NE Section 4-265-3E
Butler County, Kansas
CASING RECORD 8 5/8" @ 149'/100 sax.
4 1/2" @ 2727'/150 sax.
COMMENCED 12/18/78
COMPLETED 12/24/78
DRILLING CONTRACTOR

DUNBAR DRILLING INC.
5252 NORTH BROADWAY
WICHITA, KANSAS 67219

DRILLERS LOG

0-7	soil
284#	shale
578	shale & lime
954	lime & shale
1268	shale & lime
1538	lime & shale
1790	lime & shale
2029	shale & lime
2223	lime & shale
2390	lime
2544	lime
2655	lime
2733	lime
2733	R. T. D.

RECEIVED
STATE CORPORATION COMMISSION

JUL 11 1979

CONSERVATION DIVISION
Wichita, Kansas