

NOTICE OF INTENTION TO DRILL

(see rules on reverse side)

Expected Spud Date... 10 8 1988 month day year

API Number 15-015-23,103-00-00

DA East

OPERATOR: License # 5120 Name Range Oil Company, Inc. Address 125 N. Market, Suite 1120 City/State/Zip Wichita, Kansas 67202 Contact Person John M. Washburn Phone (316) 265-6231

APP W/2 E/2 NE Sec. 8 Twp. 26 S, Rg. 3 3880 Ft. from South Line of Section 1150 Ft. from East Line of Section

(Note: Locate well on Section Plat on reverse side)

CONTRACTOR: License # 5124 Name Range Drilling Co., Inc. City/State Wichita, Kansas 67202

Nearest lease or unit boundary line 1150 feet County Butler Lease Name Wolf Well # 1 Ground surface elevation 1337 feet MSL Domestic well within 330 feet: yes no X Municipal well within one mile: yes no X Depth to bottom of fresh water 130 Depth to bottom of usable water 200 Surface pipe by Alternate: 1 X 2 Surface pipe planned to be set 200 Conductor pipe required Projected Total Depth 2820 feet Formation Mississippian

Well Drilled For: Well Class: Type Equipment: X Oil Storage Infield X Mud Rotary Gas Inj X Pool Ext Air Rotary OWWO Expl Wildcat Cable

If OWWO: old well info as follows:

Operator Well Name Comp Date Old Total Depth

I certify that well will comply with K.S.A. 55-101, et seq., plus eventually plugging hole to KCC specifications.

Date 9-9-88 Signature of Operator or Agent John M. Washburn Title Vice President/Exploration

For KCC Use:

Conductor Pipe Required feet; Minimum Surface Pipe Required 200 feet per Alt. 1 X

This Authorization Expires 3-9-89 Approved By LKM 9-9-88


EFFECTIVE DATE: 9-14-88

Must be filed with the K.C.C. five (5) days prior to commencing well
This card void if drilling not started within six (6) months of date received by K.C.C.

Important procedures to follow:

1. Notify District office before setting surface casing.
2. Set surface casing by circulating cement to the top.
3. File completion forms ACO-1 with K.C.C. within 120 days of well spud date, following instructions on ACO-1, side 1, and including copies of wireline logs.
4. Notify District office 48 hours prior to old well workover or re-entry.
5. Prior to filing Intent, prepare a proposed plugging plan in case well is D & A, then obtain approval of plan when calling district office prior to setting surface pipe.
6. Submit plugging report (CP-4) to K.C.C. after plugging is completed.
7. Obtain an approved injection docket number before disposing of salt water.
8. Notify K.C.C. within 10 days when injection commences or terminates.
9. If an alternate 2 completion, cement in the production pipe from below any usable water to surface within 120 days of spud date.

A Regular Section of Land 1 Mile = 5,280 Ft.

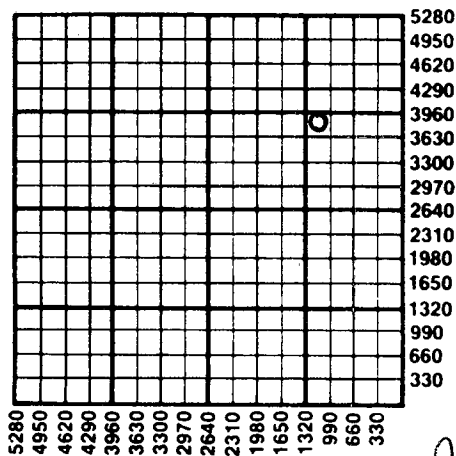

*Revd
09-09-88*

State Corporation Commission of Kansas
Conservation Division
200 Colorado Derby Building
Wichita, Kansas 67202-1212
(316) 263-3238