

CARD MUST BE TYPED

# NOTICE OF INTENTION TO DRILL

State of Kansas  
(see rules on reverse side)

CARD MUST BE SIGNED

Starting Date: 8 15 84  
month day year

API Number 15- 173-20,666-0000

OPERATOR: License # 5313 75'  
Name F & M OIL CO., INC.  
Address 422 Union Center  
City/State/Zip Wichita, Kansas 67202  
Contact Person R. D. Messinger  
Phone (316)262-2636

SW of NE NE SE Sec 33 Twp 26S, Rge 2E  East  West  
(location)

2257 Ft North from Southeast Corner of Section  
383 Ft West from Southeast Corner of Section  
(Note: Locate well on Section Plat on reverse side)

CONTRACTOR: License # 5840  
Name Brandt Drilling Co., Inc.  
City/State Wichita, Kansas 67202

Nearest lease or unit boundary line 330 feet.  
County Sedgwick  
Lease Name Luening "A" Well# 1

Well Drilled For: Well Class: Type Equipment:  
 Oil  Swd  Infield  Mud Rotary  
 Gas  Inj  Pool-Ext.  Air Rotary  
 OWWO  Expl  Wildcat  Cable

Domestic well within 330 feet:  yes  no  
Municipal well within one mile:  yes  no

If OWWO: old well info as follows:  
Operator N/A  
Well Name \_\_\_\_\_  
Comp Date \_\_\_\_\_ Old Total Depth \_\_\_\_\_  
Projected Total Depth 3375' feet  
Projected Formation at TD Simpson  
Expected Producing Formations Simpson

Depth to Bottom of fresh water 95 feet  
Lowest usable water formation None Wellington  
Depth to Bottom of usable water 200 feet  
Surface pipe by Alternate: 1  2   
Surface pipe to be set 250 feet  
Conductor pipe if any required \_\_\_\_\_ feet  
Ground surface elevation \_\_\_\_\_ feet MSL  
This Authorization Expires 2/12/85  
Approved By 8/2/84

I certify that we will comply with K.S.A. 55-101, et seq., plus eventually plugging hole to K.C.C. specifications.

Date 8-1-84 Signature of Operator or Agent


*R. D. Messinger* Title Vice-President  
mhc/KOHE 8/2/84

Must be filed with the K.C.C. five (5) days prior to commencing well  
This card void if drilling not started within six (6) months of date received by K.C.C.

RECEIVED  
COMMISSION

8-2-84  
AUG 02 1984

**A Regular Section of Land  
1 Mile = 5,280 Ft.**

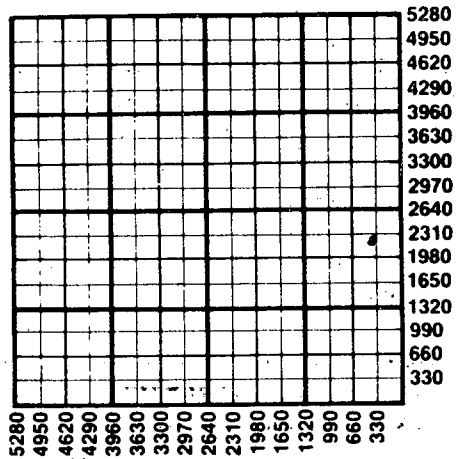

**Important procedures to follow:**

CONSERVATION DIVISION  
Wichita, Kansas

1. Notify District office before setting surface casing.
2. Set surface casing by circulating cement to the top.
3. File completion forms ACO-1 with K.C.C. within 90 days of well completion, following instructions on ACO-1, side 1, and including copies of wireline logs.
4. Notify District office 48 hours prior to old well workover or re-entry.
5. Prior to plugging, prepare a plugging plan, then obtain agreement from the appropriate district office for an approved plugging plan.
6. Submit plugging report (CP-4) to K.C.C. after plugging is completed.
7. Obtain an approved injection docket number before disposing of salt water.
8. Notify K.C.C. within 10 days when injection commences or terminates.
9. If an alternate 2 completion, cement in the production pipe from below any usable water to surface within 120 days of spud date.

**State Corporation Commission of Kansas  
Conservation Division  
200 Colorado Derby Building  
Wichita, Kansas 67202  
(316) 263-3238**