


STATE OF KANSAS
STATE CORPORATION COMMISSION

Form CP-4

Give All Information Completely
Make Required Affidavit
Mail or Deliver Report to:
Conservation Division
State Corporation Commission
212 No. Market
Wichita, Kansas 67202

WELL PLUGGING RECORD

Butler County, Sec. 7 Twp. 26 Rge. 3 (E) X XWX
Location as "NE/CNWxSWx" or footage from lines CWL, NW SE NE
Lease Owner Reed Parker
Lease Name Carol R. Hinnenkamp Well No. 1
Office Address 1347 So. Washington Ave., Wichita, Kansas
Character of Well (completed as Oil, Gas or Dry Hole) Oil
Date well completed _____ 19____
Application for plugging filed April 21 1972
Application for plugging approved April 21 1972
Plugging commenced May 25 1972
Plugging completed June 5 1972
Reason for abandonment of well or producing formation Dry

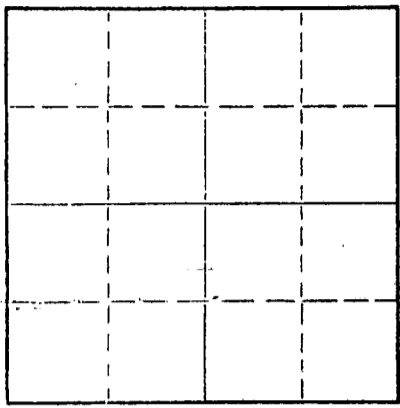

Locate well correctly on above Section Plat

If a producing well is abandoned, date of last production _____ 19____
Was permission obtained from the Conservation Division or its agents before plugging was commenced? Yes

Name of Conservation Agent who supervised plugging of this well Eugene Graham and Ted Dewey
Producing formation _____ Depth to top _____ Bottom _____ Total Depth of Well 2818' Feet
Show depth and thickness of all water, oil and gas formations.

OIL, GAS OR WATER RECORDS

CASING RECORD

FORMATION	CONTENT	FROM	TO	SIZE	PUT IN	PULLED OUT
				8 5/8"	200'	None
				5 1/2"	2812'	2271'

Describe in detail the manner in which the well was plugged, indicating where the mud fluid was placed and the method or methods used in introducing it into the hole. If cement or other plugs were used, state the character of same and depth placed, from _____ feet to _____ feet for each plug set.

Fill back with sand to 2800' , dumped 5 sacks cement with dump baylor
Set 10' rock bridge from 210' to 200' filled casing with 5 yds. redy-mix cement

RECEIVED
STATE CORPORATION COMMISSION
JUN 12 1972
6-12-72
CONSERVATION DIVISION
Wichita, Kansas


(If additional description is necessary, use BACK of this sheet)
Name of Plugging Contractor Robert Self
Address R.R. #4, Hutchinson, Kansas

STATE OF Kansas, COUNTY OF Reno, ss.
I Robert Self (Employee of Owner) or (owner or operator) of the above-described

well, being first duly sworn on oath, says: That I have knowledge of the facts, statements, and matters herein contained and the log of the above described well as filed and that the same are true and correct. So help me God.

(Signature) Robert Self
R.R. #4, Hutchinson, Kansas
(Address)

Subscribed and sworn to before me this 5th day of June, 1972
October 18, 1973
My commission expires

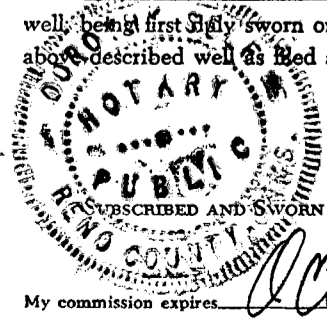

Notary Public.

TRIANGLE DRILLING

324 North Orchard
EL DORADO, KANSAS

9

To Cheryl Ann Oil Co.

Invoice No. _____

Wichita, Kansas

Date September 19, 1970

7-26-3E ✓

For Month Of _____

Lease Hinnenkamp #1 Butler County Kansas

WELL LOG

0	-----	71	Line and Shale
71	-----	197	Line
197	-----	290	Line And Shale
290	-----	528	Shale and Shells
528	-----	770	Shale and Line
770	-----	1100	Line and Shale
1100	-----	1330	Shale and Shells
1330	-----	1550	Shale and Line
1550	-----	1935	Shale and Line
1935	-----	2205	Line and Shale
2205	-----	2300	Line
2300	-----	2391	Line and Shale
2391	-----	2554	Line
2554	-----	2770	Line and Shale
2770	-----	2818	Line Miss. R.T.D.