


WELL PLUGGING RECORD

Give All Information Completely  
Make Required Affidavit  
Mail or Deliver Report to:  
Conservation Division  
State Corporation Commission  
800 Bitting Building  
Wichita, Kansas

NORTH

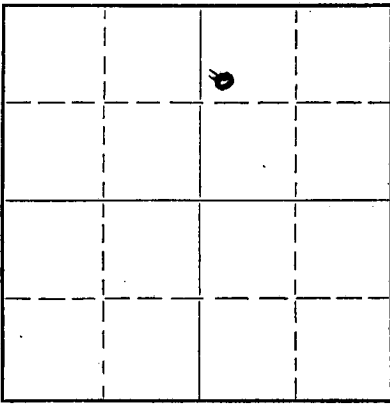

Locate well correctly on above  
Section Plat

Butler County. Sec. 7 Twp. 26 Rge. 3 (E) 1420  
Location as "NE/CNW $\frac{1}{4}$ SW $\frac{1}{4}$ " or footage from lines SW NW NE  
Lease Owner Penguin Petroleum, Inc.  
Lease Name Holder Well No. #1  
Office Address 708 Petroleum Building, Wichita, Kansas  
Character of Well (completed as Oil, Gas or Dry Hole) Oil Well  
Date well completed 3-30 19 49  
Application for plugging filed 4-30 19 52  
Application for plugging approved 4-30 19 52  
Plugging commenced 4-30 19 52  
Plugging completed 4-30 19 52  
Reason for abandonment of well or producing formation Ceased producing oil.

If a producing well is abandoned, date of last production April 28, 19 52  
Was permission obtained from the Conservation Division or its agents before plugging was commenced? Yes

Name of Conservation Agent who supervised plugging of this well Lawrence W. Matthews  
Producing formation Mississippian Depth to top 2803' Bottom Total Depth of Well 2854' Feet  
Show depth and thickness of all water, oil and gas formations.

OIL, GAS OR WATER RECORDS

CASING RECORD

Formation	Content	From	To	Size	Put In	Pulled Out
				8 5/8"	72.40'	None
				5 1/2"	2806'	2492'

Describe in detail the manner in which the well was plugged, indicating where the mud fluid was placed and the method or methods used in introducing it into the hole. If cement or other plugs were used, state the character of same and depth placed, from feet to feet for each plug set.

Mud to 2800' and dumped 3 sxs. cement @ 2800'

Mud to 200', set 10' sxs cement on 15' Rock Bridge @ 185'

Mud to surface, set 5 sxs cement cap.

RECEIVED  
STATE CORPORATION COMMISSION  
MAY - 9 1952  
5-9-52  
CONSERVATION DIVISION  
Wichita, Kansas

(If additional description is necessary, use BACK of this sheet)  
Name of Plugging Contractor Chet Myers Well Servicing  
Address Masonic Building Augusta, Kansas


STATE OF KANSAS, COUNTY OF SEDGWICK, ss.  
W. G. Talbott (employee of owner) or (owner or operator) of the above-described well,  
being first duly sworn on oath, says: That I have knowledge of the facts, statements, and matters herein contained and the log of the above-described well as filed and that the same are true and correct. So help me God.

(Signature) W. G. Talbott  
708 Petroleum Building Wichita, Kansas  
(Address)

SUBSCRIBED AND SWORN to before me this 8th day of May, 19 52

My commission expires November 1, 1953

Jay English  
Notary Public.

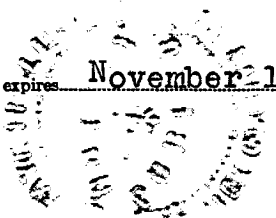

23-8390-s 6-51-20M  
PLUGGING  
FILE SEC 7 T 26 R 56  
BOOK PAGE 14 LINE 24

Company: Penguin Petroleum, Inc.  
Farm: holder #1  
Comm: March 14, 1949  
Comp: March 30, 1949  
Contractor: Penguin Petroleum, Inc.

Section 7, T 26 S, R 3 E  
SW NW NE  
Butler County, Kansas  
Rotary Tools  
Elevation: 1336' R.B.  
Total Depth: 2854'  
Initial Potential:

Casing: 8 5/8" @ 72'  
5 1/2" @ 2806'

0-35	Shale
-45	Sand
-60	Shale
-70	Lime
-300	Shale, lime and gyp.
-460	Lime broken
-475	Sandy lime
-790	Lime broken
-795	Lime
-1160	Shale & lime
-1200	Shale & shells
-1290	Shale
-1340	Lime
-1435	Shale & shells
-1670	Shale & lime
-1865	Lime & shale
-2020	Shale & shells
-2065	Shale & lime
-2185	Lime broken
-2305	Lime
-2345	Shale
-2505	Lime
-2615	Shale
-2705	Shale & lime
-2803	Shale & lime
-2820	Chert
-2826	White chert
-2833	Buff dolomite
-2839	Buff dolomite & glauconitic chert
-2841	White chat
-2846	Chat
-2854	Chert

Total Depth 2854'

Plugged back to 2838'

Tops: Kansas City limestone @ 2345'  
Lansing @ 2110'  
Mississippian limestone @ 2804'

Certified to be a true copy of the well log as indicated on daily drilling reports.

Penguin Petroleum, Inc.

by Jack Brown

Subscribed and sworn to before me, the undersigned, a Notary Public in and for Sedgwick County, Kansas, this 1st day of April, 1949.

My Commission Expires:

October 13, 1952

**RECEIVED**  
STATE CORPORATION COMMISSION

B. D. Strickland  
Notary Public

**PLUGGING** MAY - 9 1952  
FILE SEC 7T-26-36 RECONSTRUCTION DIVISION  
BOOK PAGE 17 LINE 24 Kansas