

STATE OF KANSAS
STATE CORPORATION COMMISSION

Form CP-4

Give All Information Completely
Make Required Affidavit
Mail or Deliver Report to:
Conservation Division
State Corporation Commission
212 No. Market
Wichita, Kansas

WELL PLUGGING RECORD

Butler County. Sec. 7 Twp. 26 Rge. 3E (E) 11/4

Location as "NE/CNW/SW" or footage from lines. C S/2 NW NW
Lease Owner Wofford Oil Company

Lease Name A. E. Edson Well No. 2

Office Address 1258 Cleveland Wichita, Ks.

Character of Well (completed as Oil, Gas or Dry Hole) D&A

Date well completed 4/4/65 19

Application for plugging filed 4/4/65 19

Application for plugging approved 4/4/65 19


Plugging commenced 4/4/65 19

Plugging completed 4/4/65 19

Reason for abandonment of well or producing formation

If a producing well is abandoned, date of last production 19

Was permission obtained from the Conservation Division or its agents before plugging was commenced? Yes

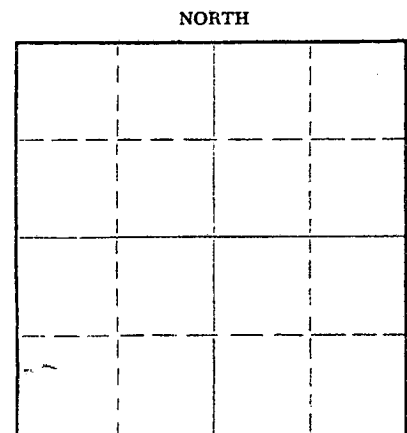

Locate well correctly on above Section Plat

Name of Conservation Agent who supervised plugging of this well Paul Turpin

Producing formation Depth to top Bottom Total Depth of Well 2866' Feet

Show depth and thickness of all water, oil and gas formations.


OIL, GAS OR WATER RECORDS

CASING RECORD

Table with 7 columns: FORMATION, CONTENT, FROM, TO, SIZE, PUT IN, PULLED OUT. The table is currently empty.

Describe in detail the manner in which the well was plugged, indicating where the mud fluid was placed and the method or methods used in introducing it into the hole. If cement or other plugs were used, state the character of same and depth placed, from feet to feet for each plug set.

Mudded hole with 40 Vis. Mud to 225 Ft. Added 1/2 sack hulls, set a dry hole plug. Added 20 sacks cement. Mudded hole from this point to 30 ft., added 1/4 sack hulls, set a plug - added 8 sacks cement. Mudded Rat hole to 8 ft. of surface and dumped 2 sacks cement. 205 ft. of 8 5/8" surface Pipe, cemented with 170 sacks cement.

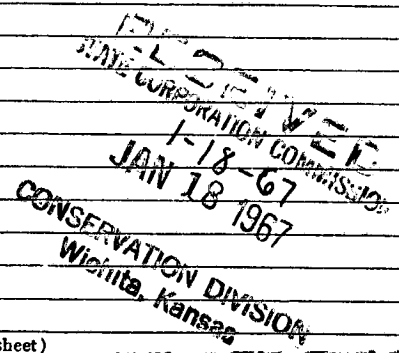

(If additional description is necessary, use BACK of this sheet)

Name of Plugging Contractor Company Tools
Address

STATE OF Kansas COUNTY OF Sedgwick, ss.

Mertha Fountain for Henry L Wofford (employee of owner) of the above-described well, being first duly sworn on oath, says: That I have knowledge of the facts, statements, and matters herein contained and the log of the above-described well as filed and that the same are true and correct. So help me God.

(Signature) Henry L Wofford by Mertha Fountain
1258 Cleveland (Address)

SUBSCRIBED AND SWORN TO before me this 6th day of September, 1966

Glenn D. Murray Notary Public.

My commission expires 4-27-67