

KANSAS CORPORATION COMMISSION
OIL & GAS CONSERVATION DIVISION
WELL PLUGGING APPLICATION
Please TYPE Form and File ONE Copy

Form CP-1
September 2003
This Form must be Typed
Form must be Signed
All blanks must be Filled

API # 15-03-21294-00-00 (Identifier Number of this well). This must be listed for wells drilled since 1967; if no API # was issued, indicate original spud or completion date 01-16-2002

Well Operator: Pickrell Drilling Company, Inc. KCC License #: 5123
(Owner / Company Name) (Operator's)

Address: 100 S. Main, Suite 505 City: Wichita

State: Kansas Zip Code: 67202 Contact Phone: (316) 262-8427

Lease: Bird N Well #: 1 Sec. 3 Twp. 32S S. R. 19W East West

E/2 SW SW Spot Location / QQQQ County: Comanche

660 Feet (in exact footage) From North / South (from nearest outside section corner) Line of Section (Not Lease Line)

990 Feet (in exact footage) From East / West (from nearest outside section corner) Line of Section (Not Lease Line)

Check One: Oil Well Gas Well D&A Cathodic Water Supply Well

KCC Pkt SWD Docket # ENHR Docket # Other:

Conductor Casing Size: 13 3/8 Set at: 189 Cemented with: 300 Sacks

Surface Casing Size: 8 5/8 Set at: 686 Cemented with: 335 Sacks

Production Casing Size: 4 1/2 Set at: 5420 Cemented with: 200 Sacks

List (ALL) Perforations and Bridgeplug Sets: 5240-5244 & 5231-5234 & 5200-5210 Miss., 5027-5031 Altamont (squeezed)

See also well sketch attached

Elevation: 2087 (G.L. / K.B.) T.D.: 6258 PBTD: 5392 Anhydrite Depth: Heebner 4322
(Stone Corral Formation)

Condition of Well: Good Poor Casing Leak Junk in Hole

Proposed Method of Plugging (attach a separate page if additional space is needed): Plug back w/ sand to 4950. Use dump bailer to dump 5 sx. cement on top of sand. Cut and recover 4 1/2" casing. Spot cement plugs as required by State Representative as pull out of hole.

Is Well Log attached to this application as required? Yes No Is ACO-1 filed? Yes No

If not explain why? **RECEIVED**
KANSAS CORPORATION COMMISSION
SEP 12 2008

Plugging of this Well will be done in accordance with K.S.A. 55-101 et. seq. and the Rules and Regulations of the State Corporation Commission. CONSERVATION DIVISION
WICHITA, KS

List Name of Company Representative authorized to be in charge of plugging operations: Deon Howard

Phone: (620) 532-3511

Address: 2485 S. State Rd. 14 City / State: Kingman, Kansas 67068-8629

Plugging Contractor: Quality Well Service KCC License #: 31925
(Company Name) (Contractor's)

Address: 190 US Highway 56, Ellinwood, KS 67526 Phone: (620) 727-3410

Proposed Date and Hour of Plugging (if known?): October 15, 2008

Payment of the Plugging Fee (K.A.R. 82-3-118) will be guaranteed by Operator or Agent

Date: 09-11-08 Authorized Operator / Agent: *Deon Howard*
(Signature)

Mail to: KCC - Conservation Division, 1301 S. Market - Room 2078, Wichita, Kansas 67202

Dist 1
PT


Oil Company _____
Company Man _____

Well No. 1
Date Drilled Jan 2002

Field _____
County Comanche

Lease Bird "N"
State Kansas

Elev.: 2092 KB
2087 GL

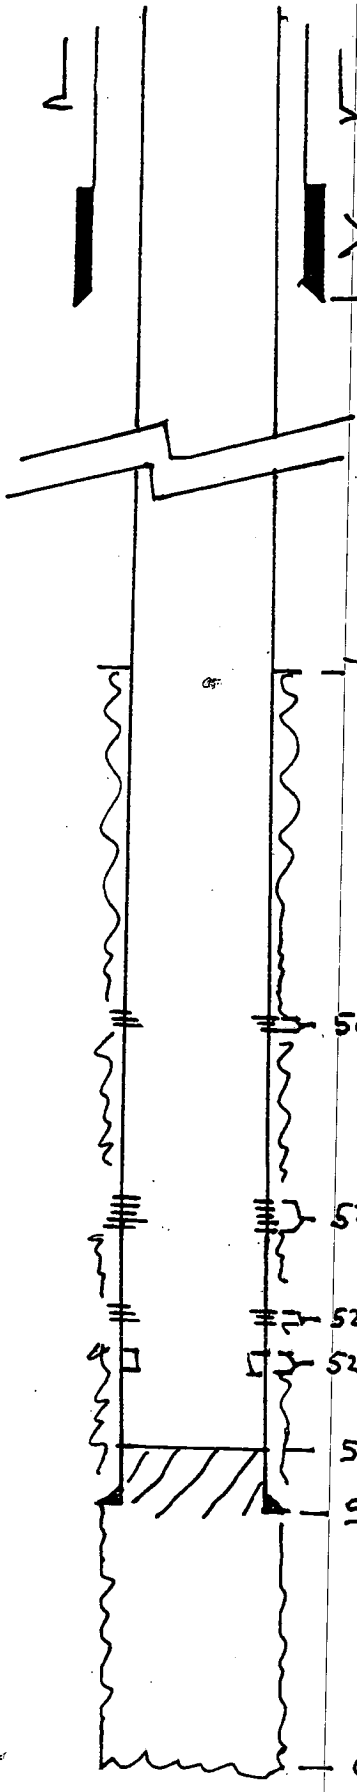

-189 Base 1 3/8 48.0 # 4/300 Sx

> 4C 520'

686 Base 8 9/8 24.0 # 4/235 Sx Uite plus 100 Sx Cl. A. Did not circ. Cement down back side w/ 100 Sx to surface

E/2 SW SW Sec 3-325-19W

API # 15-033-21294

T.O.C. 4780

5027-5031 (Attachment Parts -- Squeezed)

5200-5200 (2 SPF)

5231-5234 (4 SPF)

5240-5244

} Miss

5392 PSTD (Loggers)

5420 Base 4 1/2 10.5 # 4/200 Sx Cl A 10% Salt

6258 LTD (Arb)

RECEIVED
KANSAS CORPORATION COMMISSION
SEP 12 2008
CONSERVATION DIVISION
WICHITA, KS



CORPORATION COMMISSION

Kathleen Sebelius, Governor · Thomas E. Wright, Chairman · Michael C. Moffet, Commissioner · Joseph F. Harkins, Commissioner

NOTICE OF RECEIPT OF WELL PLUGGING APPLICATION (CP-1)

PICKRELL DRILLING COMPANY, INC.
100 S MAIN STE 505
WICHITA, KS 67202-3738

September 17, 2008

Re: BIRD N #1
API 15-033-21294-00-00
3-32S-19W, 660 FSL 990 FWL
COMANCHE COUNTY, KANSAS

Dear Operator:

This letter is to notify you that the Conservation Division has received your plugging proposal, form CP-1, for the above well and has reviewed the proposal for completeness. The central office will now forward your CP-1 to the district office listed below for review of the proposed plugging method. **Please contact the district office for approval of your proposed plugging method at least five (5) days before plugging the well, pursuant to K.A.R. 82-3-113(b). If a workover pit will be used during the plugging of the well it must be permitted. A CDP-1 form must be filed and approved prior to the use of the pit in accordance with K.A.R. 82-3-600.**

The Conservation Division's review of form CP-1, either in the central or district office, does not include an inquiry into well ownership or the filing operator's legal right to plug the well. This notice in no way constitutes authorization to plug the above well by persons not having legal rights of ownership or interest in the well.

This notice is void after March 16, 2009. The CP-1 filing does not bring the above well into compliance with K.A.R. 82-3-111 with regard to the Commission's temporary abandonment requirements.

District: #1
210 E Frontview, Suite A
Dodge City, KS 67801
(620) 225-8888

Sincerely,

Steve Bond
Production Department Supervisor