

CARD MUST BE TYPED

State of Kansas  
**NOTICE OF INTENTION TO DRILL**  
(see rules on reverse side)

CARD MUST BE SIGNED

Starting Date: March 31 1985  
month day year

API Number 15-065-22,169-00-00

OPERATOR: License # 4036

NE 1/4 SW 1/4 11 10 22  East  
(location) Sec Twp S, Rge  West

Name PITTMAN & ASSOCIATES, INC.  
Address 5921 So. Middlefield Rd., S. 200  
City/State/Zip Littleton, Colorado 80123  
Contact Person Karalee Belt  
Phone (303) 795-6914

990 ft. ~~XXXXXXXXXXXXXXXXXXXXXXXXXXXXXXXX~~  
4290 ft. ~~XXXXXX from Southeast Corner of Section~~  
(Note: Locate well on Section Plat on reverse side)

CONTRACTOR: License # 5137

Nearest lease or unit boundary line 990 ft. Section

Name J. W. Drilling Co., Inc.  
City/State Wichita, Kansas

County Graham  
Lease Name Des Marteau Well# 1-11

Well Drilled For: Well Class: Type Equipment:  
 Oil  Swd  Infield  Mud Rotary  
 Gas  Inj  Pool Ext.  Air Rotary  
 OWWO  Expl  Wildcat  Cable

Domestic well within 330 feet:  yes  no  
Municipal well within one mile:  yes  no

If OWWO: old well info as follows:  
Operator .....  
Well Name .....  
Comp Date ..... Old Total Depth .....  
Projected Total Depth 3,900 feet  
Projected Formation at TB Arbuckle  
Expected Producing Formations Lansing/KC, Marmaton

Depth to Bottom of fresh water 190 feet  
Lowest usable water formation DAKOTA  
Depth to Bottom of usable water 670 1000 feet  
Surface pipe by Alternate: 1  2   
Surface pipe to be set 250 feet  
Conductor pipe if any required ..... feet  
Ground surface elevation 2,295 feet MSL

I certify that we will comply with K.S.A. 55-101, et seq., plus eventually plugging hole to K.C.C. specifications.

This Authorization Expires 9-28-85  
Approved By [Signature] KC

Date 3/20/85 Signature of Operator or Agent [Signature] Title .....

MHC/MOHE 3-28-85  
President


Must be filed with the K.C.C. five (5) days prior to commencing well  
This card void if drilling not started within six (6) months of date received by K.C.C.

RECEIVED  
STATE CORPORATION COMMISSION  
03-28-1985  
MAR 28 1985

**Important procedures to follow:**

CONSERVATION DIVISION  
Wichita, Kansas

**A Regular Section of Land**  
1 Mile = 5,280 Ft.

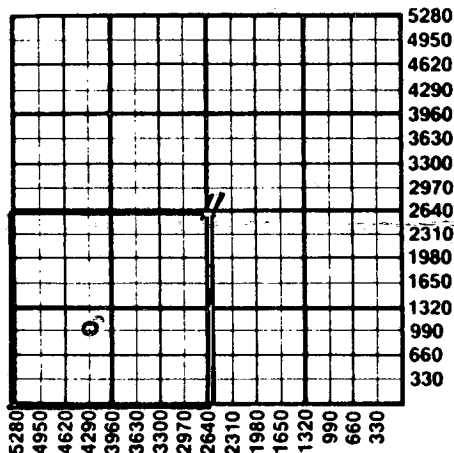

1. Notify District office before setting surface casing.
2. Set surface casing by circulating cement to the top.
3. File completion forms ACO-1 with K.C.C. within 90 days of well completion, following instructions on ACO-1, side 1, and including copies of wireline logs.
4. Notify District office 48 hours prior to old well workover or re-entry.
5. Prior to plugging, prepare a plugging plan, then obtain agreement from the appropriate district office for an approved plugging plan.
6. Submit plugging report (CP-4) to K.C.C. after plugging is completed.
7. Obtain an approved injection docket number before disposing of salt water.
8. Notify K.C.C. within 10 days when injection commences or terminates.
9. If an alternate 2 completion, cement in the production pipe from below any usable water to surface within 120 days of spud date.

State Corporation Commission of Kansas  
Conservation Division  
200 Colorado Derby Building  
Wichita, Kansas 67202  
(316) 263-3238