

NOTICE OF INTENTION TO DRILL

(see rules on reverse side)

Starting Date January 20, 1986 month day year

API Number 15- 065-22,296-00-00

OPERATOR: License # 5252 Name R.P. Nixon Address 207 W. 12th St. City/State/Zip Hays KS 67601 Contact Person Dan A. Nixon Phone 913-628-3834

NE SE SW Sec. 16 Twp. 10 S, Rg. 22 990 2970 East West Ft. from South Line of Section Ft. from East Line of Section

(Note: Locate well on Section Plat on reverse side)

CONTRACTOR: License # 5128 Rig Tag #36 Name Jay-Lan Corp. City/State Hays KS 67601

Nearest lease or unit boundary line 330 feet County Graham Lease Name Griffith Well # 1

Well Drilled For: Well Class: Type Equipment: Oil SWD Infield Mud Rotary Gas Inj Pool Ext Air Rotary OWWO Expl Wildcat Cable

Ground surface elevation feet MSL Domestic well within 330 feet: yes no Municipal well within one mile: yes no Surface pipe by Alternate: 1 2 X 3 Depth to bottom of fresh water 100 Depth to bottom of usable water 200 1000 Surface pipe planned to be set 200 Projected Total Depth 3850 Formation Conglomerate

If OWWO: old well info as follows:

Operator Well Name Comp Date Old Total Depth

I certify that well will comply with K.S.A. 55-101, et seq., plus eventually plugging hole to KCC specifications.

X cementing will be done immediately upon setting production casing.

Date 1-13-86 Signature of Operator or Agent Title Geologist

For KCC Use:

Conductor Pipe Required feet; Minimum Surface Pipe Required 200 feet per ft.


This Authorization Expires 7-14-86 Approved By 1-14-86

Must be filed with the K.C.C. five (5) days prior to commencing well
This card void if drilling not started within six (6) months of date received by K.C.C.

Important procedures to follow:

1. Notify District office before setting surface casing.
2. Set surface casing by circulating cement to the top.
3. File completion forms ACO-1 with K.C.C. within 90 days of well completion, following instructions on ACO-1, side 1, and including copies of wireline logs.
4. Notify District office 48 hours prior to old well workover or re-entry.
5. Prior to filing Intent, prepare a proposed plugging plan in case well is D & A, then obtain approval of plan when calling district office prior to setting surface pipe.
6. Submit plugging report (CP-4) to K.C.C. after plugging is completed.
7. Obtain an approved injection docket number before disposing of salt water.
8. Notify K.C.C. within 10 days when injection commences or terminates.
9. If an alternate 2 completion, cement in the production pipe from below any usable water to surface within 120 days of spud date.

A Regular Section of Land 1 Mile = 5,280 Ft.

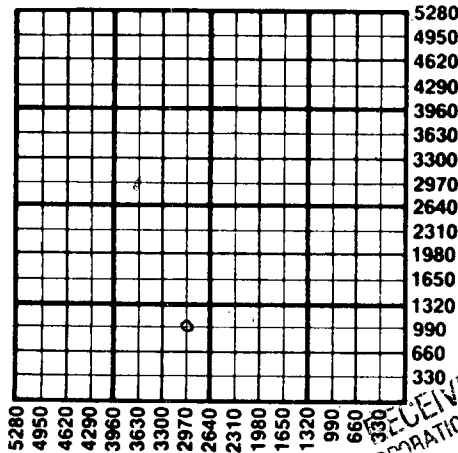

RECEIVED
STATE CORPORATION COMMISSION
JAN 14 1986
CONSERVATION DIVISION
Wichita, Kansas

State Corporation Commission of Kansas
Conservation Division
200 Colorado Derby Building
Wichita, Kansas 67202
(316) 263-3238