


STATE OF KANSAS  
STATE CORPORATION COMMISSION

Give All Information Completely  
Make Required Affidavit  
Mail or Deliver Report to:  
Conservation Division  
State Corporation Commission  
211 No. Broadway  
Wichita, Kansas

15-065-00557-00-00  
WELL PLUGGING RECORD

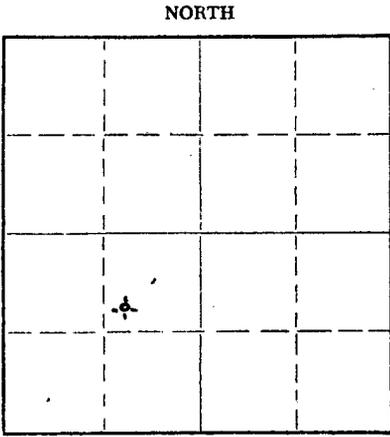

Locate well correctly on above  
Section Plat

GRAHAM County. Sec. 7 Twp. 10S Rge. 22W (E) (W)  
Location as "NE/CNW/SW" or footage from lines SE NE SW  
Lease Owner THE KIMBARK Co. SE ADJ R22  
Lease Name DELTON Well No. 1  
Office Address P. O. Box 1557, DENVER 1, COLORADO  
Character of Well (completed as Oil, Gas or Dry Hole) DRY HOLE  
Date well completed JUNE 22, 19 58  
Application for plugging filed (VERBAL) " " 19 "  
Application for plugging approved (" ") " " 19 "  
Plugging commenced " " 19 "  
Plugging completed " " 19 "  
Reason for abandonment of well or producing formation DRY HOLE

If a producing well is abandoned, date of last production \_\_\_\_\_ 19\_\_\_\_  
Was permission obtained from the Conservation Division or its agents before plugging was commenced? YES

Name of Conservation Agent who supervised plugging of this well EDWIN PETTY  
Producing formation \_\_\_\_\_ Depth to top \_\_\_\_\_ Bottom \_\_\_\_\_ Total Depth of Well 3920 Feet  
Show depth and thickness of all water, oil and gas formations.

OIL, GAS OR WATER RECORDS

CASING RECORD

FORMATION	CONTENT	FROM	TO	SIZE	PUT IN	PULLED OUT
		0	201'	8-5/8	193'	NONE

Describe in detail the manner in which the well was plugged, indicating where the mud fluid was placed and the method or methods used in introducing it into the hole. If cement or other plugs were used, state the character of same and depth placed, from \_\_\_\_\_ feet to \_\_\_\_\_ feet for each plug set.

PLUGGED HOLE WITH 25 SACKS CEMENT ON BOTTOM. PLUG SET AT 600' AND 15 SACKS CEMENT ON PLUG AT 190' AND 10 SACKS CEMENT AT TOP OF SURFACE PIPE AT 40'.

RECEIVED  
STATE CORPORATION COMMISSION  
JUL 24 1958  
07-24-1958  
CONSERVATION DIVISION  
Wichita, Kansas


(If additional description is necessary, use BACK of this sheet)

Name of Plugging Contractor LOGAN DRILLING COMPANY  
Address P. O. Box 1557, DENVER 1, COLORADO

STATE OF COLORADO, COUNTY OF DENVER, ss.  
WALTER K. ARBUCKLE (employee of owner) or (owner or operator) of the above-described well, being first duly sworn on oath, says: That I have knowledge of the facts, statements, and matters herein contained and the log of the above-described well as filed and that the same are true and correct. So help me God.

(Signature) Walter K. Ar buckle  
P. O. Box 1557, DENVER 1, COLORADO  
(Address)

Subscribed and sworn to before me this 23 day of JULY, 19 58  
Joe B. Thompson  
Notary Public.

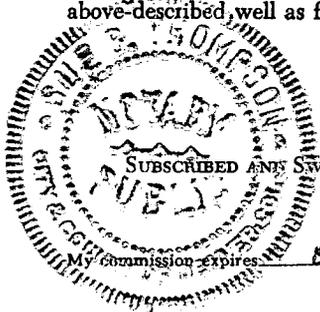

PLUGGING  
FILE SEC 7 T 10 R 22W  
BOOK PAGE 117 LINE 37

15-065-00582-00-00

DELTON #1 WELL LOG

LOCATION: SE SE NW SECTION 7  
T-10-S, R-22-W  
GRAMHAM COUNTY, KANSAS

SPUDDED: 7/9/58  
COMPLETED: 7/18/58

OWNER: THE KIMBARK COMPANY  
P. O. Box 1557  
DENVER 1, COLORADO

CONTRACTOR: LOGAN DRILLING COMPANY  
P. O. Box 1557  
DENVER 1, COLORADO

SURFACE CASING: 8-5/8" SS CASING CEMENTED AT 202 W/135 SACKS.

OIL STRING: ---

LOG

FIGURES INDICATE BOTTOM OF FORMATION

204	SHALE AND SAND
1025	SHALE
1535	SHALE AND SAND
1650	SAND AND SHALE
1922	SHALE AND RED BED
1945	ANHYDRITE
2055	LIME
2277	SHALE AND LIME
2480	LIME AND SHALE
2630	LIME
2755	LIME AND SHALE
2900	LIME AND SHALE
3055	SHALE AND LIME
3150	LIME AND SHALE
3300	LIME AND SHALE
3420	SHALE AND LIME
3511	SHALE AND LIME
3643	LIME AND CHALK
3710	LIME
3733	SHALE AND LIME
3807	LIME AND SHALE
3814	LIME
3824	LIME
3840	LIME
3852	LIME AND SHALE
3905	SHALE AND LIME
3905	ROTARY TOTAL DEPTH

THE UNDERSIGNED, W. K. ARBUCKLE, PRESIDENT OF THE LOGAN DRILLING COMPANY, HEREBY CERTIFIES THAT THE ABOVE IS A TRUE AND CORRECT LOG OF THE FORMATIONS ENCOUNTERED IN DRILLING THE DELTON #1 AS SHOWN IN THE DAILY DRILLING REPORTS.

LOGAN DRILLING COMPANY


*W. K. Arbuckle*  
\_\_\_\_\_  
W. K. ARBUCKLE, PRESIDENT

STATE OF COLORADO )  
CITY & COUNTY OF DENVER )

BE IT REMEMBERED, THAT ON THIS 25TH DAY OF AUGUST A.D., 1958, BEFORE ME *Audrey Davis*, a NOTARY PUBLIC PERSONALLY APPEARED W. K. ARBUCKLE, PRESIDENT OF LOGAN DRILLING COMPANY, A COLORADO CORPORATION, WHO IS PERSONALLY KNOWN TO ME AND KNOWN TO BE THE PRESIDENT OF SAID CORPORATION, AND THE SAME PERSON WHO EXECUTED THE FOREGOING INSTRUMENT, AND HE DULY ACKNOWLEDGED THE EXECUTION OF THE SAME FOR AND ON BEHALF OF AND AS THE ACT AND DEED OF SAID CORPORATION.

WITNESS MY HAND AND OFFICIAL SEAL.  
MY COMMISSION EXPIRES August 20, 1960.

*Audrey Davis*  
NOTARY PUBLIC

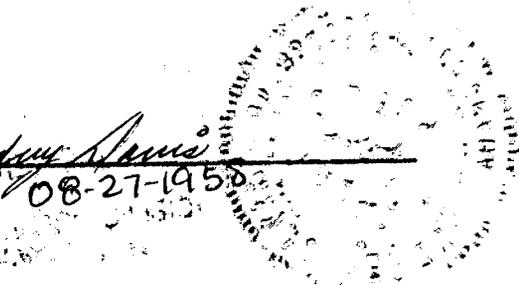

PLUGGING  
FILE SEC. 7 T. 10 R. 22W  
BOOK PAGE 117 LINE 37