


WELL PLUGGING RECORD

Give All Information Completely  
Make Required Affidavit  
Mail or Deliver Report to:  
Conservation Division  
State Corporation Commission  
800 Bittling Building  
Wichita, Kansas

Graham County. Sec. 12 Twp. 10S Rge. 22 (NW) (W)  
Location as "NE/CNW $\frac{1}{4}$ SW $\frac{1}{4}$ " or footage from lines NW NW NW  
Lease Owner Clyde G. Kissinger  
Lease Name R. L. Thomas Well No. I  
Office Address.....  
Character of Well (completed as Oil, Gas or Dry Hole) Dry Hole  
Date well completed 8/26/ 1950  
Application for plugging filed 8/25 1950  
Application for plugging approved 8/26 1950  
Plugging commenced 8/26 1950  
Plugging completed 8/26 1950  
Reason for abandonment of well or producing formation Dry through Arbuckle

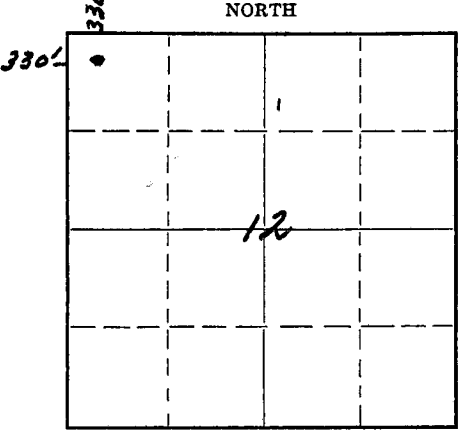

Locate well correctly on above Section Plat

If a producing well is abandoned, date of last production..... 19.....  
Was permission obtained from the Conservation Division or its agents before plugging was commenced? Yes

Name of Conservation Agent who supervised plugging of this well Mr. Holland  
Producing formation..... Depth to top..... Bottom..... Total Depth of Well 4053 Feet  
Show depth and thickness of all water, oil and gas formations.

OIL, GAS OR WATER RECORDS

CASING RECORD

Formation	Content	From	To	Size	Put In	Pulled Out
<u>Surface</u>	<u>8 5/8"</u>	<u>0</u>	<u>163</u>	<u>8 5/8</u>		<u>None</u>

Describe in detail the manner in which the well was plugged, indicating where the mud fluid was placed and the method or methods used in introducing it into the hole. If cement or other plugs were used, state the character of same and depth placed, from..... feet to..... feet for each plug set.

Hole circulated on bottom with heavy mud for one hour and spotted fifteen (15) sacks cement at bottom of surface (163) and ten (10) sacks cement four feet (4) below surface.

(Cement spotted with Halliburton.)

Set 12 1051  
09-12-1950

(If additional description is necessary, use BACK of this sheet)  
Correspondence regarding this well should be addressed to Clyde G. Kissinger  
Address Russell, Kansas

STATE OF....., COUNTY OF....., ss.  
..... (employee of owner) or (owner or operator) of the above-described well, being first duly sworn on oath, says: That I have knowledge of the facts, statements, and matters herein contained and the log of the above-described well as filed and that the same are true and correct. So help me God.


(Signature) Clyde G. Kissinger

SUBSCRIBED AND SWORN TO before me this 11th day of Sept., 1950

(Address) Wayne Mersweather  
Notary Public.

My commission expires.....

22-7377-s 4-49-10M

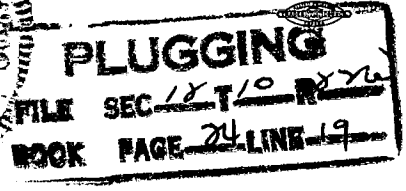

15-065-00158-00-00

WELL LOG

R. L. THOMAS # 1 Well

Well located in Section 12, Township  
10 South, Range 22 West, Graham  
County, Kansas

FORMATION	FROM	TO
Sand	0	65
Shale	65	190
Sand & Stone	190	295
Shale	295	625
Shale & Shells	625	1315
Sand & Shells	1315	1450
Sand	1450	1540
Shale, Shells & Red Beds	1540	1795
Anhydrite	1795	1830
Shale & Shells	1830	1975
Red Bed	1975	2005
Shale & Shells	2005	2300
Broken Lime	2300	2485
Shale & Lime Shells	2485	2655
Broken Lime	2655	2775
Lime	2775	2835
Shale & Lime	2835	2975
Lime	2975	3055
Shale & Lime	3055	3362
Lime	3362	3553
Lime & Shale	3553	3568
Lime	3568	3833
Shale	3833	3865
Chert & Lime	3865	3936
Congl.	3936	4036
Lime	4036	4053
Total Depth	4053.	

I, the undersigned, being first duly sworn upon oath, state that this well record is true, correct and complete according to the records of this office and to the best of my knowledge and belief.

09-12-1950

G. Frederick  
G. Frederick

Subscribed and sworn to before me this 5th day of September, 1950.

Art M. Trump  
Notary Public

My commission expires  
October 14, 1953.

