

KANSAS CORPORATION COMMISSION
OIL & GAS CONSERVATION DIVISION

Form CP-1
September 2003
Form must be Typed
Form must be Signed
All blanks must be Filled

WELL PLUGGING APPLICATION

Please TYPE Form and File ONE Copy

API # 15- 081-21752-0000 (Identifier Number of this well). This must be listed for wells drilled since 1967; if no API # was issued.

Indicate original spud or completion date 9/22/2007

Well Operator: Presco Western, LLC KCC License #: 32309
(Owner/Company Name) (Operator's)

Address: 5665 Flatiron Parkway City: Boulder

State: CO Zip Code: 80301 Contact Phone: 303 305-1163

Lease: Wright Well #: 4-L33-30-32 Sec. 33 Twp. 30 R. 32 East West

SE - SE - NW - SW Spot Location/QQQQ County Haskell

1,398 Feet from (in exact footage) North / South (from nearest outside section corner) Line of Section (not Lease Line)

1,242 Feet from (in exact footage) East / West (from nearest outside section corner) Line of Section (not Lease Line)

Check One: Oil Well Gas Well D&A Cathodic Water Supply Well
 SWD Docket # _____ ENHR Docket # _____ Other _____

Conductor Casing Size: N/A Set at: N/A Cemented with: N/A Sacks

Surface Casing Size: 8-5/8" Set at: 1,761' Cemented with: 750 Sacks

Production Casing Size: 5-1/2" Set at: 5,805' Cemented with: 210 Sacks

List (ALL) Perforations and Bridgeplug Sets: Sqz perfs 5699-01/CIBP 5680/St Louis 5628-38/Sq perfs 5400-02/CIBP 5380

Elevation: 2,876' (G.L. K.B.) T.D. 5,825' PBDT 5,380 Anhydrite Depth 1,684'
(Stone Corral Formation)

Condition of Well: Good Poor Casing Leak Junk in Hole

Proposed Method of Plugging (attach a separate page if additional space is needed): As per KCC rules.

Is Well Log attached to this application as required? Yes No Is ACO-1 filed? Yes No

If not explain why? _____

Plugging of this Well will be done in accordance with K.S.A. 55-101 et. seq. and the Rules and Regulations of the State Corporation Commission

List Name of Company Representative authorized to be in charge of plugging operations:

Kevin Newman 620-309-8413 Tony Aton 620-952-2403 Phone: 620 655-1958 Kelly Tompkins

Address: 303 S. Stubbs Rd. City/State Ulysses, KS

Plugging Contractor to be determined KCC License # _____
(Company Name) (Contractor's)

Address _____ Phone: _____

Proposed Date and Hour of Plugging (if known?): _____

Payment of the Plugging Fee (K.A.R. 82-3-118) will be guaranteed by Operator or Agent

Date: 9/30/2008 Authorized Operator / Agent: Keli Kowalski
(Signature)

Keli Kowalski

RECEIVED
KANSAS CORPORATION COMMISSION
OCT 01 2008

CONSERVATION DIVISION
WICHITA, KS

ELLORA ENERGY

Date: 5/16/2008
Preparer: H. Leathers

Wellname: Wright 4-L33-30-32
Field: Wildcat
County: Haskell State: KS
aka:
API: 15-081-21752

QTR: SEENWSW
Sec: 33
Twp: 30S
Rge: 32W

Ellora ID: 696

automatic

Spud 9/23/2007

KB: 2895
DF: _____
GL: 2876
Diff: 19

Casing Information

Size	Weight	Grade	Thread	Top	Btm	Date Run
8 5/8	24	J-55			1761	9/25/2007
5 1/2	15.5	J-55			5805	10/4/2007
Port Collar					3439	10/4/2007

Tubing Information

Size or Item	Weight	Grade	Thread	Depth	# of jts	Date Run
						0/0/00
						0/0/00
						0/0/00
						0/0/00
						0/0/00

Rod Information

Size	Desc	Grade	Length	# Run	Date Run
					0/0/00
					0/0/00
					0/0/00

Pump Information


Item	Desc	Date Run
		0/0/00
		0/0/00

Producing Intervals

Formation	Top	Btm	SPF	# of holes	Date Shot	Status
St. Louis	5628	5638	4	40	1/11/2008	CIBP
				0		
				0		
				0		
				0		

Well History

9/25/2007	Cmt 8 5/8 w/ 600 sks lite (3% CC, 1/4# Floseal) & 150 sks Class C (3% CC), cmt did circulate
10/4/2007	Cmt 5 1/2 w/ 210 sks ASC (2% gel 10% salt 5# gilsonite 0.5% FL 160)
10/3/2007	DIL, SSD, Sonic logs run
12/27/2007	Perf sqz holes @ 5699-5701; pump 33 BF @ 3 bpm @ 1200 #; did not circ; RIH w/ CICR @ 5680; perf 5400-5402.
12/28/2007	RIH w/ tbg, tag CICR
12/29/2007	Pmp 100 sks cmt; did not circ; sting out of CICR
12/31/2007	tag CICR @ 5680
1/3/2008	run CBL; wait on orders
1/5/2008	RIH w/ sqz pkr @ 5340; sqz w/ 150 sks cmt; rev out, sqz to 1000
1/8-10/08	drill out cmt; circ clean; tag CICR @ 5680
1/11/2008	run CBL; swab dry
1/12/2008	Perf 5626-5638 and set pkr at 5560, acdz w/ 250 gals acid; swab dry and rec 35 bbls wtr
1/13/2008	run swab, stack out @ 3300, drlg mud in tbg; pump 40 BF dn csg & 15 BF dn tbg; POOH pkr
1/15/2008	Set CIBP @ 5380 + 2 sks cmt; LD tbg

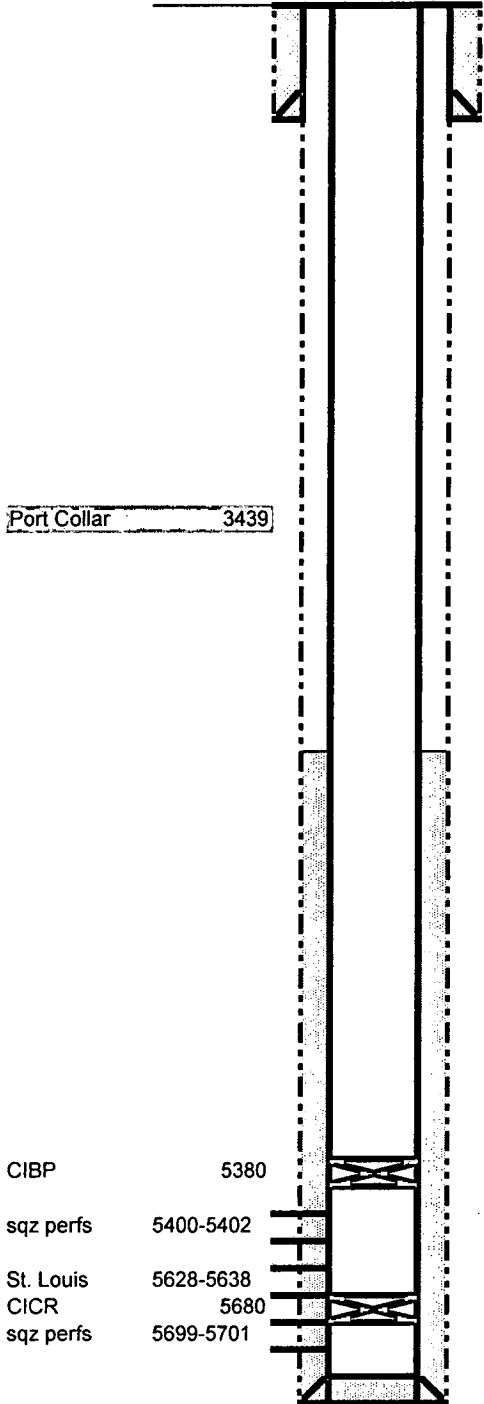

CIBP 5380
sqz perms 5400-5402
St. Louis 5628-5638
CICR 5680
sqz perms 5699-5701

TOC _____
Fill _____
PBTD 5680
RTD 5825
OHTD _____

RECEIVED
KANSAS CORPORATION COMMISSION

OCT 01 2008

CONSERVATION DIVISION
WICHITA, KS



CORPORATION COMMISSION

Kathleen Sebelius, Governor Thomas E. Wright, Chairman Michael C. Moffet, Commissioner Joseph F. Harkins, Commissioner

NOTICE OF RECEIPT OF WELL PLUGGING APPLICATION (CP-1)

PRESCO WESTERN LLC
5665 FLATIRON PKWY
BOULDER, CO 80301

October 07, 2008

Re: WRIGHT #4-L33-30-32
API 15-081-21752-00-00
33-30S-32W, 1398 FSL 1242 FWL
HASKELL COUNTY, KANSAS

Dear Operator:

This letter is to notify you that the Conservation Division has received your plugging proposal, form CP-1, for the above well and has reviewed the proposal for completeness. The central office will now forward your CP-1 to the district office listed below for review of the proposed plugging method. **Please contact the district office for approval of your proposed plugging method at least five (5) days before plugging the well, pursuant to K.A.R. 82-3-113(b). If a workover pit will be used during the plugging of the well it must be permitted. A CDP-1 form must be filed and approved prior to the use of the pit in accordance with K.A.R. 82-3-600.**

The Conservation Division's review of form CP-1, either in the central or district office, does not include an inquiry into well ownership or the filing operator's legal right to plug the well. This notice in no way constitutes authorization to plug the above well by persons not having legal rights of ownership or interest in the well.

This notice is void after April 5, 2009. The CP-1 filing does not bring the above well into compliance with K.A.R. 82-3-111 with regard to the Commission's temporary abandonment requirements.

Sincerely,

Steve Bond
Production Department Supervisor

District: #1
210 E Frontview, Suite A
Dodge City, KS 67801
(620) 225-8888