

KANSAS CORPORATION COMMISSION  
OIL & GAS CONSERVATION DIVISION

Form CP-1  
September 2003  
Form must be Typed  
Form must be Signed  
All blanks must be Filled

WELL PLUGGING APPLICATION

Please TYPE Form and File ONE Copy

API # 15- 081-21674-0000 (Identifier Number of this well). This must be listed for wells drilled since 1967; if no API # was issued.

Indicate original spud or completion date 8/24/2007

Well Operator: Presco Western, LLC KCC License #: 32309  
(Owner/Company Name) (Operator's)

Address: 5665 Flatiron Parkway City: Boulder

State: CO Zip Code: 80301 Contact Phone: 303 305-1163

Lease: Diaden Farms Well #: 1-B2-29-33 Sec. 2 Twp. 29 R. 33  East  West

W2 - NW - NW - NE Spot Location/QQQQ County Haskell

660 Feet from (in exact footage)  North /  South (from nearest outside section corner) Line of Section (not Lease Line)

2,310' Feet from (in exact footage)  East /  West (from nearest outside section corner) Line of Section (not Lease Line)

Check One:  Oil Well  Gas Well  D&A  Cathodic  Water Supply Well  
 SWD Docket # \_\_\_\_\_  ENHR Docket # \_\_\_\_\_  Other \_\_\_\_\_

Conductor Casing Size: N/A Set at: N/A Cemented with: N/A Sacks

Surface Casing Size: 8-5/8" Set at: 1,798' Cemented with: 600 Sacks

Production Casing Size: 4-1/2" Set at: 5,784' Cemented with: 290 Sacks

List (ALL) Perforations and Bridgeplug Sets: St. Louis 5672-76/CIBP 5650/Morrow 5347-60/Cherokee 4978-90/Swope <sup>5018-5020</sup> <sup>Squeezed</sup>

Elevation: 2,953' ( G.L.  K.B.) T.D. 5,790 PBDT \_\_\_\_\_ Anhydrite Depth \_\_\_\_\_  
(Stone Corral Formation)

Condition of Well:  Good  Poor  Casing Leak  Junk in Hole

Proposed Method of Plugging (attach a separate page if additional space is needed): As per KCC rules.

Is Well Log attached to this application as required?  Yes  No Is ACO-1 filed?  Yes  No

If not explain why? Temporary Abandonment Application sent in 9/18/2008.

Plugging of this Well will be done in accordance with K.S.A. 55-101 et. seq. and the Rules and Regulations of the State Corporation Commission

List Name of Company Representative authorized to be in charge of plugging operations:

Kelly Tompkins 620-655-1958 Kevin Newman 620-309-3413 Phone: 620 952-2403 Tony Aton

Address: 303 S. Stubbs Rd. City/State Ulysses, KS

Plugging Contractor to be determined KCC License # \_\_\_\_\_  
(Company Name) (Contractor's)

Address \_\_\_\_\_ Phone: \_\_\_\_\_

Proposed Date and Hour of Plugging (if known?): \_\_\_\_\_

Payment of the Plugging Fee (K.A.R. 82-3-118) will be guaranteed by Operator or Agent

Date: 9/30/2008 Authorized Operator / Agent: Keli Kowalski

(Signature)

Keli Kowalski


RECEIVED  
KANSAS CORPORATION COMMISSION

OCT 01 2008

CONSERVATION DIVISION  
WICHITA, KS

Well Name: Diaden Farms 1-B2-29-33

|                                     |   |                                  |                                |                              |
|-------------------------------------|---|----------------------------------|--------------------------------|------------------------------|
| API/UWI<br>15-081-21747-0000        | Surface Legal Location<br>Sec 2 T29S R33W W/2 NW NE | License No.                      | Field Name<br>U S 83 Northwest | State/Province<br>Kansas     |
| Well Configuration Type<br>Vertical | Original KB Elevation (ft)<br>2,964.00              | KB-Ground Distance (ft)<br>11.00 | KB-Casing Flange Distance (ft) | KB-Tubing Head Distance (ft) |

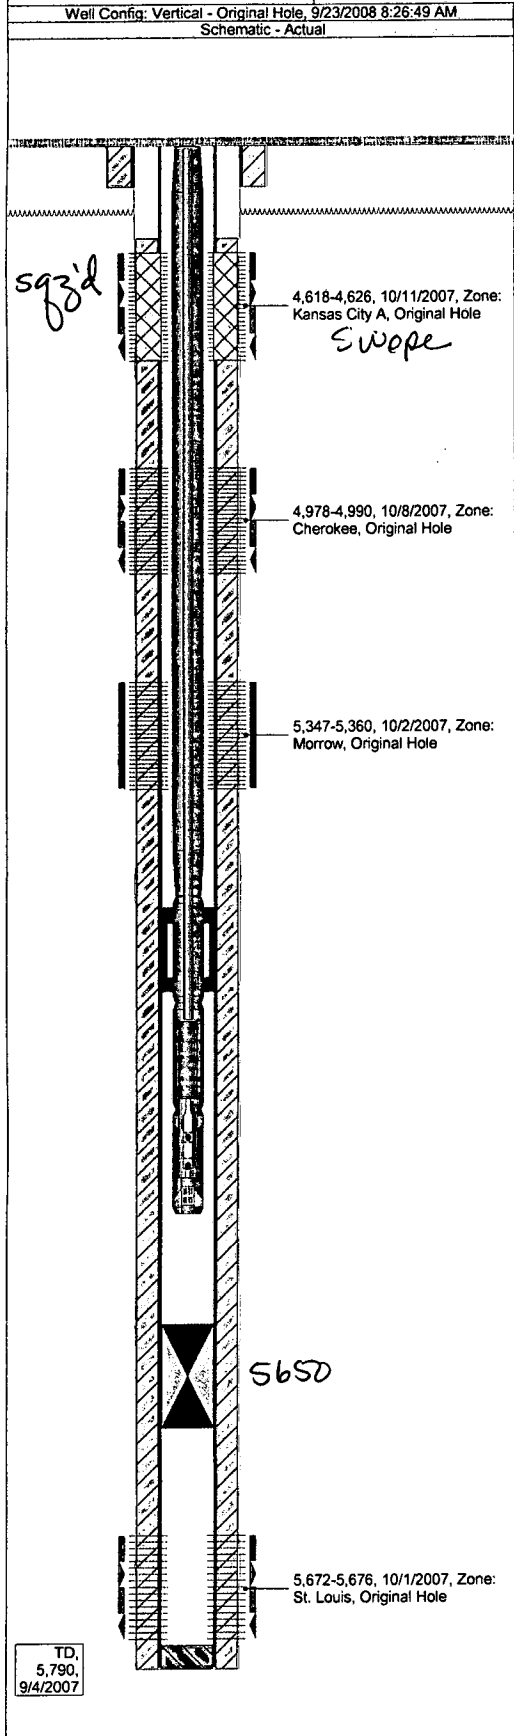

| 4,618.0-4,626.0ftKB on 10/11/2007 00:00 |                       |                     |                              |                     |                      |
|---|-----------------------|---------------------|------------------------------|---------------------|----------------------|
| Date                                    | 10/11/2007            | Zone                | Kansas City A, Original Hole | Top (ftKB)          | 4,618.0              |
| Perforation Company                     |                       | Conveyance Method   |                              | Gun Size (in)       |                      |
| Shot Density (shots/ft)                 | 4.0                   | Charge Type         |                              | Phasing (°)         |                      |
| Orientation                             |                       |                     | Orientation Method           |                     |                      |
| Over/Under Balanced                     | Over/Under Pres (psi) | FL MD Before (ftKB) | FL MD After (ftKB)           | P (init surf) (psi) | P (final surf) (psi) |
| Reference Log                           |                       |                     |                              |                     |                      |
| Perforation Statuses                    |                       |                     |                              |                     |                      |
| Date                                    |                       | Status              |                              | Comment             |                      |
|   |                       |                     |                              |                     |                      |
| 4,978.0-4,990.0ftKB on 10/8/2007 00:00  |                       |                     |                              |                     |                      |
| Date                                    | 10/8/2007             | Zone                | Cherokee, Original Hole      | Top (ftKB)          | 4,978.0              |
| Perforation Company                     |                       | Conveyance Method   |                              | Gun Size (in)       |                      |
| Shot Density (shots/ft)                 |                       | Charge Type         |                              | Phasing (°)         |                      |
| Orientation                             |                       |                     | Orientation Method           |                     |                      |
| Over/Under Balanced                     | Over/Under Pres (psi) | FL MD Before (ftKB) | FL MD After (ftKB)           | P (init surf) (psi) | P (final surf) (psi) |
| Reference Log                           |                       |                     |                              |                     |                      |
| Perforation Statuses                    |                       |                     |                              |                     |                      |
| Date                                    |                       | Status              |                              | Comment             |                      |
|   |                       |                     |                              |                     |                      |
| 5,347.0-5,360.0ftKB on 10/2/2007 00:00  |                       |                     |                              |                     |                      |
| Date                                    | 10/2/2007             | Zone                | Morrow, Original Hole        | Top (ftKB)          | 5,347.0              |
| Perforation Company                     |                       | Conveyance Method   |                              | Gun Size (in)       |                      |
| Shot Density (shots/ft)                 |                       | Charge Type         |                              | Phasing (°)         |                      |
| Orientation                             |                       |                     | Orientation Method           |                     |                      |
| Over/Under Balanced                     | Over/Under Pres (psi) | FL MD Before (ftKB) | FL MD After (ftKB)           | P (init surf) (psi) | P (final surf) (psi) |
| Reference Log                           |                       |                     |                              |                     |                      |
| Perforation Statuses                    |                       |                     |                              |                     |                      |
| Date                                    |                       | Status              |                              | Comment             |                      |
|   |                       |                     |                              |                     |                      |
| 5,672.0-5,676.0ftKB on 10/1/2007 00:00  |                       |                     |                              |                     |                      |
| Date                                    | 10/1/2007             | Zone                | St. Louis, Original Hole     | Top (ftKB)          | 5,672.0              |
| Perforation Company                     |                       | Conveyance Method   |                              | Gun Size (in)       |                      |
| Shot Density (shots/ft)                 |                       | Charge Type         |                              | Phasing (°)         |                      |
| Orientation                             |                       |                     | Orientation Method           |                     |                      |
| Over/Under Balanced                     | Over/Under Pres (psi) | FL MD Before (ftKB) | FL MD After (ftKB)           | P (init surf) (psi) | P (final surf) (psi) |
| Reference Log                           |                       |                     |                              |                     |                      |
| Perforation Statuses                    |                       |                     |                              |                     |                      |
| Date                                    |                       | Status              |                              | Comment             |                      |
|   |                       |                     |                              |                     |                      |

**Well Name: Diaden Farms 1-B2-29-33**

|                                   |   |                                  |                                |                          |                                     |
|-----------------------------------|---|----------------------------------|--------------------------------|--------------------------|-------------------------------------|
| API/UWI<br>15-081-21747-0000      | Surface Legal Location<br>Sec 2 T29S R33W W/2 NW NE | Field Name<br>U S 83 Northwest   | License No.                    | State/Province<br>Kansas | Well Configuration Type<br>Vertical |
| Ground Elevation (ft)<br>2,953.00 | Casing Flange Elevation (ft)                        | KB-Ground Distance (ft)<br>11.00 | KB-Casing Flange Distance (ft) | Spud Date<br>8/24/2007   | Rig Release Date                    |

| Date       | Event  |
|------------|--|
| 8/24/2007  | Wellbore Sections: Section: Surface; Size: 12 1/4 in; Act Top: 12.0 ftKB; Act Btm: 1,800.0 ftKB  |
| 8/26/2007  | Casing Strings: Casing Description: Surface; Set Depth: 1,798.0 ftKB; Comment: <Comment?>  |
| 8/26/2007  | Cement: Description: Surface Casing Cement; Eval Res: <Cement Evaluation Results?>; Comment: <Comment?>                                |
| 8/27/2007  | Wellbore Sections: Section: Production; Size: 7 7/8 in; Act Top: 1,800.0 ftKB; Act Btm: 5,790.0 ftKB                                   |
| 9/5/2007   | Casing Strings: Casing Description: Production; Set Depth: 5,784.0 ftKB; Comment: <Comment?>   |
| 9/5/2007   | Cement: Description: Production Casing Cement; Eval Res: <Cement Evaluation Results?>; Comment: <Comment?>                             |
| 9/5/2007   | Cement: Description: Production Casing Cement; Eval Res: <Cement Evaluation Results?>; Comment: <Comment?>                             |
| 10/1/2007  | Stimulations & Treatments: Zone: <Zone?>; Type: Acidizing; Comment: 12 bbls 15% NEFE and 35 bbls flush                                 |
| 10/1/2007  | Perforations: Proposed: <Proposed?>; Zone: St. Louis, Original Hole; Top: 5,672.0 ftKB; Btm: 5,676.0 ftKB; Shot Dens: <Shot Density?>  |
| 10/2/2007  | Other In Hole: Description: Bridge Plug - Permanent; Top: 5,650.0 ftKB; Btm: 5,653.0 ftKB; OD: 4 in                                    |
| 10/2/2007  | Perforations: Proposed: <Proposed?>; Zone: Morrow, Original Hole; Top: 5,347.0 ftKB; Btm: 5,360.0 ftKB; Shot Dens: <Shot Density?>     |
| 10/3/2007  | Stimulations & Treatments: Zone: <Zone?>; Type: Acidizing; Comment: 24 bbls 14% MCA and 35 bbls flush                                  |
| 10/4/2007  | Stimulations & Treatments: Zone: <Zone?>; Type: Acid Wash; Comment: 36 bbls 15% NEFE and 35 bbls flush                                 |
| 10/8/2007  | Perforations: Proposed: <Proposed?>; Zone: Cherokee, Original Hole; Top: 4,978.0 ftKB; Btm: 4,990.0 ftKB; Shot Dens: <Shot Density?>   |
| 10/9/2007  | Stimulations & Treatments: Zone: <Zone?>; Type: Acidizing; Comment: 12 bbls 15% MCA 30 bbls flush                                      |
| 10/11/2007 | Perforations: Proposed: <Proposed?>; Zone: Kansas City A, Original Hole; Top: 4,618.0 ftKB; Btm: 4,626.0 ftKB; Shot Dens: 4.0 shots/ft |
| 10/12/2007 | Stimulations & Treatments: Zone: <Zone?>; Type: Acidizing; Comment: 12 bbls 15% HCl 30 bbls flush                                      |
| 10/22/2007 | Cement: Description: Cement Squeeze; Eval Res: <Cement Evaluation Results?>; Comment: <Comment?>                                       |
| 10/24/2007 | Tubing Strings: Tubing Description: Tubing; Set Depth: 5,580.0 ftKB; Comment: <Comment?>   |

**RECEIVED**  
 KANSAS CORPORATION COMMISSION  
  
**OCT 01 2008**  
  
 CONSERVATION DIVISION  
 WICHITA, KS



CORPORATION COMMISSION

Kathleen Sebelius, Governor Thomas E. Wright, Chairman Michael C. Moffet, Commissioner Joseph F. Harkins, Commissioner

**NOTICE OF RECEIPT OF WELL PLUGGING APPLICATION (CP-1)**

PRESCO WESTERN LLC  
5665 FLATIRON PKWY  
BOULDER, CO 80301

October 07, 2008

Re: Diaden Farms #1-B2-29-33  
API 15-081-21747-00-00  
2-29S-33W, 660 FNL 2310 FEL  
HASKELL COUNTY, KANSAS

Dear Operator:

This letter is to notify you that the Conservation Division has received your plugging proposal, form CP-1, for the above well and has reviewed the proposal for completeness. The central office will now forward your CP-1 to the district office listed below for review of the proposed plugging method. **Please contact the district office for approval of your proposed plugging method at least five (5) days before plugging the well, pursuant to K.A.R. 82-3-113(b). If a workover pit will be used during the plugging of the well it must be permitted. A CDP-1 form must be filed and approved prior to the use of the pit in accordance with K.A.R. 82-3-600.**

The Conservation Division's review of form CP-1, either in the central or district office, does not include an inquiry into well ownership or the filing operator's legal right to plug the well. This notice in no way constitutes authorization to plug the above well by persons not having legal rights of ownership or interest in the well.

**This notice is void after April 5, 2009. The CP-1 filing does not bring the above well into compliance with K.A.R. 82-3-111 with regard to the Commission's temporary abandonment requirements.**

Sincerely,

Steve Bond  
Production Department Supervisor

District: #1  
210 E Frontview, Suite A  
Dodge City, KS 67801  
(620) 225-8888