

CARD MUST BE TYPED

NOTICE OF INTENTION TO DRILL

(see rules on reverse side)

CARD MUST BE SIGNED

Starting Date: 11 19 85¹⁹
month day year

API Number 15- 065-22, 272-00-00

OPERATOR: License # 5118

NW. SE. NE Sec 23. Twp 10S. S, Rge 22. East
(location) West

Name TGT Petroleum Corp.

Address 209 E. William

City/State/Zip Wichita, Ks. 67202

Contact Person B. Lynn Herrington

Phone 262-6489

3630 Ft North from Southeast Corner of Section
990 Ft West from Southeast Corner of Section
(Note: Locate well on Section Plat on reverse side)

CONTRACTOR: License # 5422

Nearest lease or unit boundary line 660 feet.

Name Abercrombie Drilling, Inc.

County Graham

City/State Wichita, Ks.

Lease Name Watkins Well# 1

Well Drilled For: Well Class: Type Equipment:

- Oil Swd Infield Mud Rotary
- Gas Inj Pool Ext. Air Rotary
- OWWO Expl Wildcat Cable

Domestic well within 330 feet: yes no

Municipal well within one mile: yes no

If OWWO: old well info as follows:

Depth to Bottom of fresh water 100 feet

Lowest usable water formation Dakota

Depth to Bottom of usable water 950 feet

Surface pipe by Alternate: 2" ~~1"~~

Surface pipe to be set 300 feet

Conductor pipe if any required

Ground surface elevation feet MSI

This Authorization Expires 5-15-86

Approved By 11-15-85 E. Lettko

I certify that we will comply with K.S.A. 55-101, et seq., plus eventually plugging hole to K.C.C. specifications.


Date 11-14-85 Signature of Operator or Agent B. Lynn Herrington

Ex. Vice-President

Must be filed with the K.C.C. five (5) days prior to commencing well
This card void if drilling not started within six (6) months of date received by K.C.C.

Important procedures to follow:

**A Regular Section of Land
1 Mile = 5,280 Ft.**

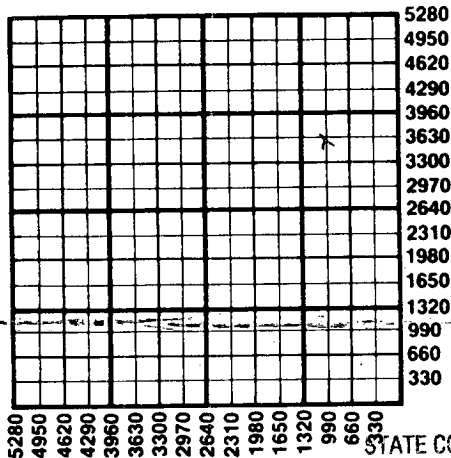

1. Notify District office before setting surface casing.
2. Set surface casing by circulating cement to the top.
3. File completion forms ACO-1 with K.C.C. within 90 days of well completion, following instructions on ACO-1, side 1, and including copies of wireline logs.
4. Notify District office 48 hours prior to old well workover or re-entry.
5. Prior to plugging, prepare a plugging plan, then obtain agreement from the appropriate district office for an approved plugging plan.
6. Submit plugging report (CP-4) to K.C.C. after plugging is completed.
7. Obtain an approved injection docket number before disposing of salt water.
8. Notify K.C.C. within 10 days when injection commences or terminates.
9. If an alternate 2 completion, cement in the production pipe from below any usable water to surface within 120 days of spud date.

RECEIVED

NOV 15 1985
11-15-1985
CONSERVATION DIVISION

STATE CORPORATION COMMISSION State Corporation Commission of Kansas
Conservation Division
200 Colorado Derby Building
Wichita, Kansas 67202
(316) 263-3238