

NOTICE OF INTENTION TO DRILL

(see rules on reverse side)

Starting Date March 15, 1986 month day year

API Number 15-065-22,310-00-00

OPERATOR: License # 5481 Name Grant Oil, Inc. Address 3190 South Wadsworth Blvd., Ste. 201 City/State/Zip Lakewood, Colorado 80227 Contact Person Bill Grant Phone (303) 980-1154

SW. NE. SW Sec. 32 Twp. 10 S, Rg. 24 West 1650 Ft. from South Line of Section 3630 Ft. from East Line of Section

(Note: Locate well on Section Plat on reverse side)

CONTRACTOR: License # 9087 Name R. & C Drilling, Inc. City/State Hays, Kansas

Nearest lease or unit boundary line 330 feet County Graham Lease Name Struss Well # 1-32

Well Drilled For: Well Class: Type Equipment: XX Oil SWD Infield XX Mud Rotary Gas Inj XX Pool Ext Air Rotary OWWO Expl Wildcat Cable

Ground surface elevation 2410 Est. feet MSL Domestic well within 330 feet: yes XX no Municipal well within one mile: yes XX no Depth to bottom of fresh water 80 Depth to bottom of usable water 1100 Surface pipe by Alternate 1 2XX

If OWWO: old well info as follows:

Operator Well Name Comp Date Old Total Depth

Surface pipe planned to be set 250 Conductor pipe required NO Projected Total Depth 4000 approx. feet Formation Lansing Kansas City

I certify that well will comply with K.S.A. 55-101, et seq., plus eventually plugging hole to KCC specifications.

Date 3/8/86 Signature of Operator or Agent N. William P. ... Title President

For KCC Use:

Conductor Pipe Required feet; Minimum Surface Pipe Required 200 feet per Alt. X (2) This Authorization Expires 7-10-86 Approved By 3-10-86 R


Ret #100#2

Must be filed with the K.C.C. five (5) days prior to commencing well  
This card void if drilling not started within six (6) months of date received by K.C.C.

### Important procedures to follow:

1. Notify District office before setting surface casing.
2. Set surface casing by circulating cement to the top.
3. File completion forms ACO-1 with K.C.C. within 90 days of well completion, following instructions on ACO-1, side 1, and including copies of wireline logs.
4. Notify District office 48 hours prior to old well workover or re-entry.
5. Prior to filing Intent, prepare a proposed plugging plan in case well is D & A, then obtain approval of plan when calling district office prior to setting surface pipe.
6. Submit plugging report (CP-4) to K.C.C. after plugging is completed.
7. Obtain an approved injection docket number before disposing of salt water.
8. Notify K.C.C. within 10 days when injection commences or terminates.
9. If an alternate 2 completion, cement in the production pipe from below any usable water to surface within 120 days of spud date.

### A Regular Section of Land 1 Mile = 5,280 Ft.

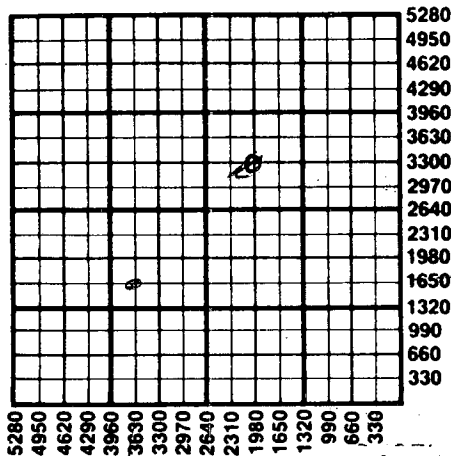

STATE CORPORATION COMMISSION

MAR 10 1985  
03-10-86  
CONSERVATION DIVISION  
Wichita, Kansas

State Corporation Commission of Kansas  
Conservation Division  
200 Colorado Derby Building  
Wichita, Kansas 67202  
(316) 263-3238