

20246
15-065-~~0129~~-00-00


STATE OF KANSAS
STATE CORPORATION COMMISSION

Form CP-4

Give All Information Completely
Make Required Affidavit
Mail or Deliver Report to:
Conservation Division
State Corporation Commission
212 No. Market
Wichita, Kansas

WELL PLUGGING RECORD

NORTH

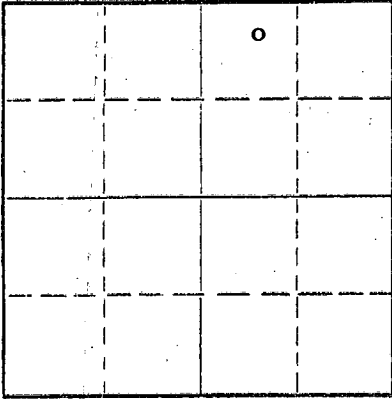

Locate well correctly on above
Section Plat

Graham County, Sec. 19 Twp. 9S Rge. 24W (E) (W)
Location as "NE/CNW/WSW" or footage from lines. NE NW NE
Lease Owner Landes Exploration Co. & Franks Petroleum Co.
Lease Name Dreiling Well No. 1
Office Address P. O. Box 867, Magnolia, Arkansas 71753
Character of Well (completed as Oil, Gas or Dry Hole) Dry Hole
Date well completed July 16 19 69
Application for plugging filed July 16 19 69
Application for plugging approved July 16 19 69
Plugging commenced July 16 19 69
Plugging completed July 16 19 69
Reason for abandonment of well or producing formation Dry Hole

If a producing well is abandoned, date of last production 19
Was permission obtained from the Conservation Division or its agents before plugging was commenced? Yes

Name of Conservation Agent who supervised plugging of this well W. L. Nichols, Moreland, Kansas 67650
Producing formation _____ Depth to top _____ Bottom _____ Total Depth of Well 3862 Feet
Show depth and thickness of all water, oil and gas formations.

OIL, GAS OR WATER RECORDS

CASING RECORD

FORMATION	CONTENT	FROM	TO	SIZE	PUT IN	PULLED OUT
		0	221'	8 5/8"	221'	None

Describe in detail the manner in which the well was plugged, indicating where the mud fluid was placed and the method or methods used in introducing it into the hole. If cement or other plugs were used, state the character of same and depth placed, from _____ feet to _____ feet for each plug set.

Plug: 1270'/100 sacks cement
245'/20 sacks cement
40'/10 sacks cement @ bridge

RECEIVED
STATE CORPORATION COMMISSION

JUL 24 1969

CONSERVATION DIVISION
Wichita, Kansas

07-24-1969

(If additional description is necessary, use BACK of this sheet)
Name of Plugging Contractor Hellar Drilling Company, Inc.
Address 339 Union Center Bldg., Wichita, Kansas 67202


STATE OF Kansas, COUNTY OF Sedgwick, ss.

D. L. Hellar, President of Hellar Drlg. Co. Inc. (Employee of owner) or (owner or operator) of the above-described well, being first duly sworn on oath, says: That I have knowledge of the facts, statements, and matters herein contained and the log of the above-described well as filed and that the same are true and correct. So help me God.

(Signature) D. L. Hellar D. L. Hellar, President
339 Union Center Bldg., Wichita, Kansas 67202
(Address)

SUBSCRIBED AND SWORN to before me this 23rd day of July, 19 69

My commission expires March 25, 1972

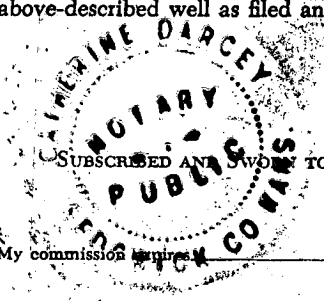

Catherine Darcey
Catherine Darcey
Notary Public.

