


WELL PLUGGING RECORD

Give All Information Completely
Make Required Affidavit
Mail or Deliver Report to:
Conservation Division
State Corporation Commission
800 Bitting Building
Wichita, Kansas

NORTH

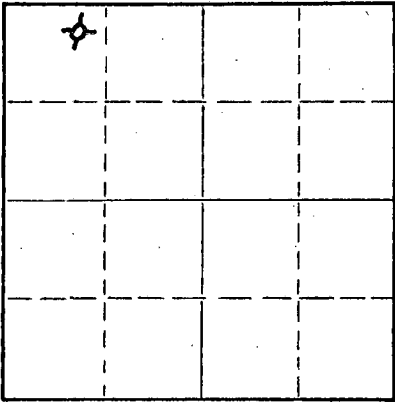

Locate well correctly on above
Section Plat

Graham County. Sec. 22 Twp. 9S Rge. (E) 24(W)
Location as "NE/CNW/SW" or footage from lines NE 1/4 - NW 1/4 - NW 1/4
Lease Owner Champlin Refining Company
Lease Name J. W. Super Well No. 1
Office Address P.O. Dr. #552, Enid, Oklahoma
Character of Well (completed as Oil, Gas or Dry Hole) Dry Hole
Date well completed January 21, 19 56
Application for plugging filed January 22, 19 56
Application for plugging approved January 22, (Verbal) 19 56
Plugging commenced January 22, 19 56
Plugging completed January 22, 19 56
Reason for abandonment of well or producing formation _____

If a producing well is abandoned, date of last production _____ 19 _____
Was permission obtained from the Conservation Division or its agents before plugging was commenced? Yes

Name of Conservation Agent who supervised plugging of this well Eldon Petty
Producing formation _____ Depth to top _____ Bottom _____ Total Depth of Well 4050 Feet
Show depth and thickness of all water, oil and gas formations.

OIL, GAS OR WATER RECORDS

CASING RECORD

FORMATION	CONTENT	FROM	TO	SIZE	PUT IN	PULLED OUT
				8 5/8"OD	203'	None

Describe in detail the manner in which the well was plugged, indicating where the mud fluid was placed and the method or methods used in introducing it into the hole. If cement or other plugs were used, state the character of same and depth placed, from _____ feet to _____ feet for each plug set.

Filled hole with heavy rotary mud from 4050' T.D. to 190'. Set Halliburton wooden plug at 190', 1/2 sack hulls and 15 sacks of cement. Then filled hole with heavy mud from top of cement to 40', set Halliburton plug, 1/2 sack of hulls and 10 sacks of cement filling hole to surface. Pumped cement in thru drill pipe.

(If additional description is necessary, use BACK of this sheet)

Name of Plugging Contractor Leo V. Wentworth Drlg. Co. (Rotary Tools)
Address Box 937, Wichita, Kansas

STATE OF Kansas COUNTY OF Barton, ss.
J. W. Meyers (employee of owner) or (owner or operator) of the above-described



well, being first duly sworn on oath, says: That I have knowledge of the facts, statements, and matters herein contained and the log of the above-described well as filed and that the same are true and correct. So help me God.

(Signature) J. W. Meyers

P.O. Box 167, Ellinwood, Kansas
(Address)

SUBSCRIBED AND SWORN to before me this 24th day of January, 1956

My commission expires Sept. 10, 1959

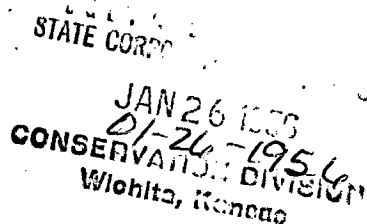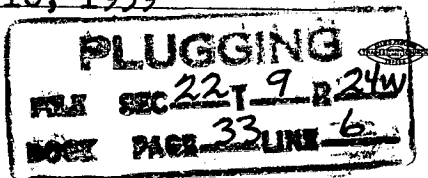

15-065-00896-00-00

TO KANSAS CORPORATION COMMISSION
Conservation Division
800 Bitting Building
Wichita, Kansas

County Graham SEC. 22 TWP. 9S RGE. 24W

COMPANY OPERATING Champlin Refining Company

OFFICE ADDRESS P.O. Dr. #552, Enid, Oklahoma

FARM NAME J. W. Super WELL NO. 1

WELL LOCATED NE $\frac{1}{4}$ - NW $\frac{1}{4}$ - NW $\frac{1}{4}$

CHARACTER OF WELL Dry Hole

4			

DRILLING COMMENCED January 7, 1956 DRILLING COMPLETED January 22, 1956

SIZE	WEIGHT	THDS	MAKE	FT.	AMOUNT PULLED	CEMENT
8 5/8"OD	24#	8rd.	New J-55	203'	None	150 sacks

FORMATION RECORD

TOPS	BOTTOM	TOPS	BOTTOM
0	110		Clay and Sand
110	205		Blue Shale
205	750		Shale
750	1375		Shale and Shells
1375	1440		Sand
1440	1620		Red Bed and Shells
1620	1700		Sand and Pyrite Shells
1700	1825		Sand, Shale and Red Bed
1825	1990		Shales and Shells
1990	2110		Shale and Red Bed
2110	2155		Anhydrite
2155	2650		Shale and Shells
2650	3040		Shale and Lime
3040	3100		Lime Shale
3100	3190		Shale and Lime
3190	3320		Lime
3320	3410		Shale and Lime
3410	3550		Lime and Shale
3550	3655		Shale and Lime
3655	3790		Lime
3790	3815		Lime and Shale
3815	4050		Lime
4050	Total Depth		

Subscribed and sworn to before me
this 24th day of January, 1956

My commission expires Sept. 10, 1959

RECEIVED
STATE CORPORATION COMMISSION
JAN 26 1956
CONSERVATION DIVISION
Wichita, Kansas

J. W. Reynolds
Superintendent

N. Kenneth Stinson
Notary Public

PLUGGING
FILE SEC 22 T 9 R 24W
