

15-065-20423-00-00

Give All Information Completely
Make Required Affidavit
Mail or Deliver Report to:
Conservation Division
State Corporation Commission
212 No. Market
Wichita, Kansas 67202

WELL PLUGGING RECORD

Graham County. Sec 24 Twp. 9 Rge. 25 (E) W (W)

Location as "NE/CNW&SW&" or footage from lines. NW SW SE

Lease Owner Thunderbird Drilling, Inc.

Lease Name Engleman Well No. 1

Office Address 4328 East Kellogg, Wichita, Kansas 67218

Character of Well (completed as Oil, Gas or Dry Hole) Dry Hole

Date well completed 3-28 19 71

Application for plugging filed 3-28 19 71

Application for plugging approved 3-28 19 71


Plugging commenced 3-28 19 71

Plugging completed 3-28 19 71

Reason for abandonment of well or producing formation Dry Hole

If a producing well is abandoned, date of last production _____ 19 _____

Was permission obtained from the Conservation Division or its agents before plugging was commenced? Yes

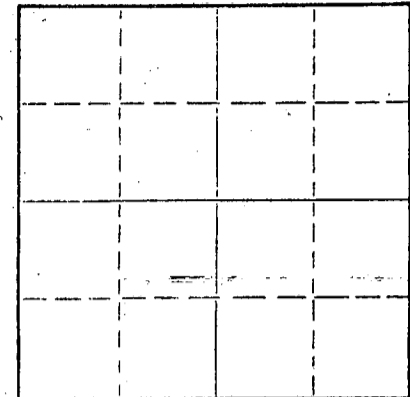

Locate well correctly on above Section Plat

Name of Conservation Agent who supervised plugging of this well Bill Nichols

Producing formation _____ Depth to top _____ Bottom _____ Total Depth of Well _____ Feet

Show depth and thickness of all water, oil and gas formations.

OIL, GAS OR WATER RECORDS

CASING RECORD

FORMATION	CONTENT	FROM	TO	SIZE	PUT IN	PULLED OUT
Surface Pipe				8 5/8"	258'	

Describe in detail the manner in which the well was plugged, indicating where the mud fluid was placed and the method or methods used in introducing it into the hole. If cement or other plugs were used, state the character of same and depth placed, from _____ feet to _____ feet for each plug set.

1st plug was set at 1300' with 100 cu. ft. cement

2nd plug was set at 275' with 25 cu. ft. cement

3rd plug was set at 40' with 10 cu. ft. cement

RECEIVED
STATE CORPORATION COMMISSION
MAR 31 1971
CONSERVATION DIVISION
Wichita, Kansas
03-31-1971

(If additional description is necessary, use BACK of this sheet)

Name of Plugging Contractor Dreiling Oil, Inc.

Address Victoria, Kansas 67671

STATE OF KANSAS, COUNTY OF ELLIS, ss.

L. Leo F. Dreiling, Pres. of Drlg. Conf. of the above-described well, being first duly sworn on oath, says: That I have knowledge of the facts, statements, and matters herein contained and the log of the above-described well as filed and that the same are true and correct. So help me God.

(Signature) Leo F. Dreiling

LEO F. DREILING, ROUTE 2, VICTORIA, KANSAS 67671

(Address)

SUBSCRIBED AND SWORN TO before me this 30th day of March, 19 71

My commission expires July 13, 1975

Patty Dreiling
PATTY DREILING
Notary Public.



DREILING OIL, INC.

Victoria, Kansas 67671

15-065-20423-00-00

WELL LOG

Company	Thunderbird Drilling, Inc. 4328 East Kellogg Wichita, Kansas 67218	Sec. 24	Twp. 9	Rng. 25
Farm	Engleman No. 1	Location	NW SW SE	
Total Depth	3914'	County	Graham	
Comm.	3-23-71	Comp.	3-28-71	Elevation: 2587' K. B.
Contractor	Dreiling Oil, Inc. Victoria, Kansas 67671			2584' D. F.
				2582' G. B.

Casing Record	Cement Record	Production:
258' - 8 5/8"	175 sacks cement	D & A

Figures Indicate Bottom of Formations

0'	210'	Top Soil, Sand & Gravel
210'	258'	Blue Shale
258'	835'	Shale
835'	1558'	Shale
1558'	2100'	Shale
2100'	2274'	Shale
2274'	2313'	Anhydrite
2313'	2363'	Shale
2363'	2765'	Shale
2765'	2962'	Shale
2962'	3125'	Shale & Lime
3125'	3286'	Shale & Lime
3286'	3435'	Shale
3435'	3538'	Shale & Lime
3538'	3710'	Shale & Lime
3710'	3885'	Lime
3885'	3914'	Lime
3914'	T.D.	

RECEIVED
STATE CORPORATION COMMISSION
MAR 31 1971
CONSERVATION DIVISION
Wichita, Kansas

STATE OF KANSAS)
)ss
COUNTY OF ELLIS)

I, Leo F. Dreiling, of Dreiling Oil, Inc., upon oath states that the above and foregoing is a true and correct copy from the Daily Drilling Report from your Engleman #1.

Leo F. Dreiling

LEO F. DREILING

Subscribed and sworn to before me this 30th day of March, 1971.

Patty Dreiling

PATTY DREILING NOTARY PUBLIC

