


Give All Information Completely
Make Required Affidavit
Mail or Deliver Report to:
Conservation Division
State Corporation Commission
212 No. Market
Wichita, Kansas

WELL PLUGGING RECORD

NORTH

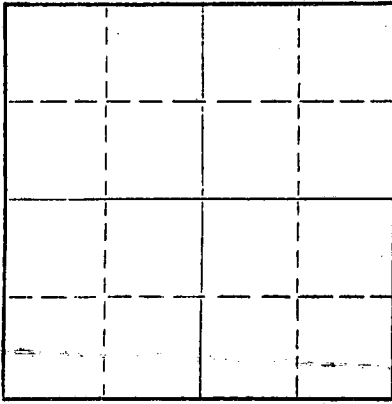

Locate well correctly on above Section Plat

Sheridan County. Sec. 1 Twp. 9S Rge. 30 (W)
Location as "NE/CNWxSWx" or footage from lines SE NW SE
Lease Owner Abercrombie Drilling, Inc.
Lease Name MEIER Well No. 1
Office Address 801 Union Center; Wichita, Kansas
Character of Well (completed as Oil, Gas or Dry Hole) Dry Hole
Date well completed December 20, 19 68
Application for plugging filed (verbally) December 20, 19 68
Application for plugging approved (verbally) December 20, 19 68
Plugging commenced December 20, 19 68
Plugging completed December 20, 19 68
Reason for abandonment of well or producing formation

If a producing well is abandoned, date of last production 19
Was permission obtained from the Conservation Division or its agents before plugging was commenced? Yes

Name of Conservation Agent who supervised plugging of this well W. L. Nichols
Producing formation Depth to top Bottom Total Depth of Well 4250 Feet
Show depth and thickness of all water, oil and gas formations.

OIL, GAS OR WATER RECORDS

CASING RECORD

FORMATION	CONTENT	FROM	TO	SIZE	PUT IN	PULLED OUT
				7"	315'	None

Describe in detail the manner in which the well was plugged, indicating where the mud fluid was placed and the method or methods used in introducing it into the hole. If cement or other plugs were used, state the character of same and depth placed, from feet to feet for each plug set.

Set 1st plug @ 1600' w/60 sx. cement;
Set 2nd plug @ 335' w/15 sx. cement;
Set top plug @ 40' w/10 sx. cement.
Job was completed at 6:00 a.m., 12-20-68.

RECEIVED
STATE CORPORATION COMMISSION
DEC 30 1968
CONSERVATION DIVISION
Wichita, Kansas

12-30-1968

Name of Plugging Contractor Abercrombie Drilling, Inc.
Address (Office) 801 Union Center; Wichita, Kansas

(If additional description is necessary, use BACK of this sheet)

STATE OF KANSAS, COUNTY OF SEDGWICK, ss.
A. L. Abercrombie (employee of owner) or (owner or operator) of the above-described

well, being first duly sworn on oath, says: That I have knowledge of the facts, statements, and matters herein contained and the log of the above-described well as filed and that the same are true and correct. So help me God.

(Signature) A. L. Abercrombie
801 Union Center; Wichita, Kansas
(Address)

Subscribed and sworn to before me this 26th day of December, 19 68.



Sue J. Blunck
Sue J. Blunck, Notary Public.

15-179-20170-00-00
 CONTRACTOR'S WELL LOG

OWNER: ABERCROMBIE DRILLING, INC.
 CONTRACTOR: ABERCROMBIE DRILLING, INC.
 WELL NAME: MEIER #1
 LOCATION: SE NW SE, SEC. 1-9S-30W
 SHERIDAN COUNTY, KANSAS
 COMMENCED: DECEMBER 11, 1968
 COMPLETED: DECEMBER 20, 1968

Drilled 328' of 9" surface hole and set 7" casing @315 w/115 sx. Sunset cement.
 Cement circulated. Plug was down at 10:00 p.m., 12-11-68.
 Dry & Abandoned.

0	100	Clay & Shale
100	665	Shale
665	1400	Shale & Shells
1400	1540	Dakota Sand
1540	2220	Shale
2220	2355	Sand
2355	2546	Shale
2546	2580	Anhydrite
2580	3000	Shale
3000	3110	Lime & Shale
3110	3330	Shale & Lime
3330	3880	Lime & Shale
3880	3995	Shale & Lime
3995	4250	Lime
	4250	Rotary Total Depth

FORMATION SAMPLE TOPS			ELEVATION
Top/Anhydrite	2546	(+ 368)	2914 K. B.
Howard	3668	(- 754)	2912 D. F.
Topeka	3749	(- 835)	2906 G. L.
Heebner	3964	(-1050)	
Toronto	3987	(-1073)	
Lansing	4001	(-1087)	
Base/K. C.	4249	(-1335)	

RECEIVED
 STATE CORPORATION COMMISSION
 DEC 30 1968
 CONSERVATION DIVISION
 Wichita, Kansas
 12-30-1968

STATE OF KANSAS)
) SS
 COUNTY OF SEDGWICK)

A. L. Abercrombie, President of Abercrombie Drilling, Inc., does hereby state that the above and foregoing is a true and correct copy of the log of the MEIER #1, SE NW SE, Sec. 1-9S-30W, Sheridan County, Kansas.

ABERCROMBIE DRILLING, INC.
 By: A. L. Abercrombie
 A. L. Abercrombie, President

Sworn to before me, a Notary Public in and for the State of Kansas, County of Sedgwick, as of the 26th day of December, 1968.

My Commission Expires:
 July 15, 1972

Sue J. Blunck
 Sue J. Blunck, Notary Public