

Rec'd 08-05-81

WELL PLUGGING RECORD

Give All Information Completely
Make Required Affidavit
Mail or Deliver Report to
Conservation Division
State Corporation Comm.
245 North Water
Wichita, KS 67202

Sheridan County Sec. 5 Twp. 9s Rge. 30 E/
Location as "NE/CNW/SW" or footage from lines

C NE NE SW

Lease Owner Geodessa Corporation

Lease Name Schultz "A" Well No. #1

Office Address 1125 -17th St Suite 2220 Denver, Co. 80202

Character of Well (Completed as Oil, Gas or Dry Hole)

Dry Hole

Date Well completed July 14 19 81

Application for plugging filed July 14 19 81

Application for plugging approved July 14 19 81

Plugging commenced 9:30 A.M. July 14 19 81

Plugging completed 10:45 A.M. July 14 19 81

Reason for abandonment of well or producing formation

No Commercial Production

If a producing well is abandoned, date of last production

19


Was permission obtained from the Conservation Division or its agents before plugging was commenced? Yes

Name of Conservation Agent who supervised plugging of this well Gil Balthazor

Producing formation Depth to top Bottom Tl. Depth of Well

Show depth and thickness of all water, oil and gas formations.

locate well correctly
on above
Section Plot

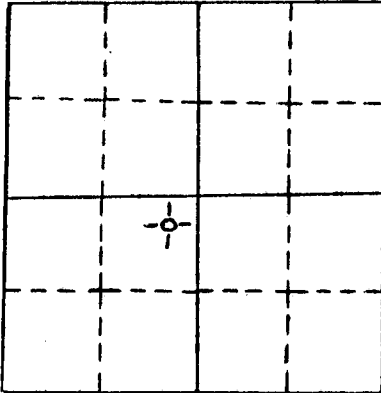

OIL, GAS OR WATER RECORDS

CASING RECORD

FORMATION	CONTENT	FROM	TO	SIZE	PUT IN	PULLED OUT
Surface casing	common	0'	332.03'	8 5/8"	332.03'	0'

Describe in detail the manner in which the well was plugged, indicating where the mud fluid was placed and the method or methods used in introducing it into the hold. If cement or other plugs were used, state the character of same and depth placed, from feet to feet for each plug set.

Plug #1 1580' with 60 sxs

Plug #2 350' with 30 sxs

Plug #3 40' with 10sxs

5 sxs in rathole

Total - 105 sxs 50-50- pos 6% gel 3% cc

P.D. @ 10:45 A.M.

(If additional description is necessary, use BACK of this sheet)

Name of Plugging Contractor Pioneer Drilling Co., Inc.
308 West Mill Plainville, Ks 67663

STATE OF COLORADO COUNTY OF Denver, ss.

E. C. Schuett


(employee of owner) or (owner or operator) of the

above described well, being first duly sworn on oath, says: That I have knowledge of the facts, statements, and matters herein contained and the log of the above described well is filed and that the same are true and correct. So help me God.

(Signature) E. Schuett

(Address) 1125 17th, #2220, Denver, CO 80202

Subscribed and sworn to before me this 29th day of July, 19 81

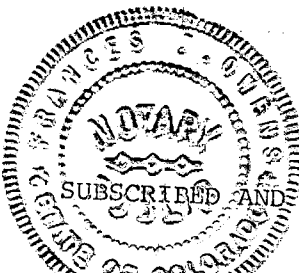

My commission expires October 26, 1981

Frances W. Owens
Notary Public
Frances W. Owens

15-179-20584-00-00

WELL LOG

OPERATOR: Geodessa Corporation

WELL NAME: Schultz "A" #1 LOCATION: C NE NE SW 5-9s-30W

COUNTY: Sheridan STATE: Kansas

WELL COMMENCED: July 6, 1981 WELL COMPLETED: July 14, 1981

ELEVATION: 2971' G.L. TOTAL DEPTH: 4325'

PRODUCTION: D & A RIG NO: #2

CASING - 8 5/8": 8 Jts new 20# 332.03' cemented with 250 sxs common 2% gel 3%cc
5 1/2": P.D. @ 1:30 P.M. July 7, 1981

ALL MEASUREMENTS TAKEN FROM THE TOP OF ROTARY BUSHING:

FROM	TO	FORMATION	DEVIATION FROM VERTICAL	REMARKS:
0'	341'	sand	341' - 3/4 degree	
341'	1060'	sand and shale		
1060'	2030'	sand and shale		
2030'	2130'	sand and shale	2130' - 1/2 degree	
2130'	2235'	sand and shale		
2235'	2570'	sand and shale		
2570'	2589'	shale and lime		
2589'	2625'	anhydrite		
2625'	2820'	shale and lime		
2820'	3069'	lime and shale		
3069'	3310'	lime and shale		
3310'	3485'	lime and shale		
3485'	3500'	lime and shale		
3500'	3618'	lime and shale		
3618'	3734'	lime and shale		
3734'	3900'	lime and shale		
3900'	4027'	lime and shale		
4027'	4090'	lime and shale		
4090'	4180'	lime and shale		
4180'	4277'	lime and shale		
4277'	4325'	lime and shale	4325' - 3/4 degree	
4325'	R.T.D.			

RECEIVED
STATE CORPORATION COMMISSION
JUL 24 1981
CONSERVATION DIVISION
Wichita, Kansas
07-24-1981

STATE OF KANSAS
COUNTY OF

The undersigned hereby certifies that to the best of his knowledge and belief, the above facts are true and correct

JUDY SMITH
NOTARY PUBLIC
STATE OF KANSAS
My Appt. Expires 1-5-85

PIONEER DRILLING CO., INC.

By Stacy A. Helgeson

SUBSCRIBED AND SWORN TO, BEFORE ME, This 17th day of July, 1981

Judy Smith
NOTARY PUBLIC