

15-179-20251-00-00

STATE OF KANSAS
STATE CORPORATION COMMISSION

Form CP-4

Give All Information Completely
Make Required Affidavit
Mail or Deliver Report to:
Conservation Division
State Corporation Commission
212 No. Market
Wichita, Kansas 67202

WELL PLUGGING RECORD

Sheridan County, Sec. 9 Twp. 9 Rge. 30 (E) W (W)

Location as "NE/CNW/SW" or footage from lines C NW NE

Lease Owner Shields Oil Producers, Inc.

Lease Name Schlitz #1-A Well No. 1A

Office Address Shields Building, Russell, Kansas 67665

Character of Well (completed as Oil, Gas or Dry Hole) Dry Hole

Date well completed 5-23 19 70

Application for plugging filed 5-23 19 70

Application for plugging approved 5-23 19 70


Plugging commenced 5-23 19 70

Plugging completed 5-23 19 70

Reason for abandonment of well or producing formation Dry Hole

If a producing well is abandoned, date of last production 19

Was permission obtained from the Conservation Division or its agents before plugging was commenced? Yes

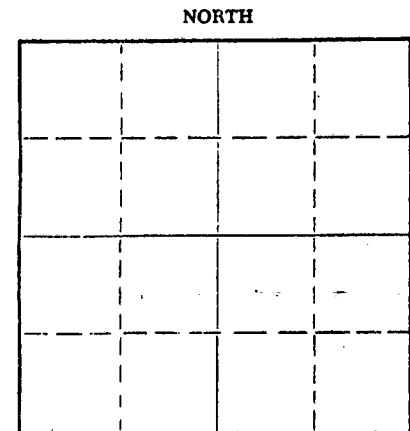

Locate well correctly on above Section Plat

Name of Conservation Agent who supervised plugging of this well Bill Nichols

Producing formation _____ Depth to top _____ Bottom _____ Total Depth of Well _____ Feet

Show depth and thickness of all water, oil and gas formations.

OIL, GAS OR WATER RECORDS

CASING RECORD

FORMATION	CONTENT	FROM	TO	SIZE	PUT IN	PULLED OUT
Surface Pipe				8 5/8"	294'	

Describe in detail the manner in which the well was plugged, indicating where the mud fluid was placed and the method or methods used in introducing it into the hole. If cement or other plugs were used, state the character of same and depth placed, from _____ feet to _____ feet for each plug set.

1st Plug was set @ 1575' with 100 sacks cement

2nd Plug was set @ 310' with 25 sacks cement

3rd Plug was set @ 40' with 30 sacks cement

RECEIVED
STATE CORPORATION COMMISSION
MAY 26 1970
CONSERVATION DIVISION
Wichita, Kansas
05-26-1970

(If additional description is necessary, use BACK of this sheet)

Name of Plugging Contractor L. J. Dreiling & Sons, Inc.

Address Victoria, Kansas 67671

STATE OF KANSAS, COUNTY OF ELLIS, ss.

I, Leo F. Dreiling (employee of owner) or (~~owner or operator~~) of the above-described well, being first duly sworn on oath, says: That I have knowledge of the facts, statements, and matters herein contained and the log of the above-described well as set and that the same are true and correct. So help me God.


(Signature) Leo F. Dreiling
LEO F. DREILING, ROUTE #2, VICTORIA, KANSAS 67671

(Address)

SUBSCRIBED AND SWORN to before me this 25th day of May, 19 70

My commission expires September 19, 1970

Joseph A. Hess
JOSEPH A. HESS Notary Public.

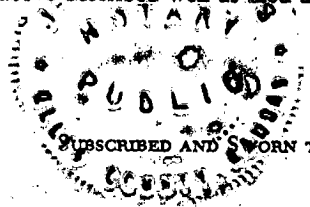

L. J. DREILING AND SONS, INC.

Victoria, Kansas 67671

WELL LOG

15-179-20251-00-00

Company Shields Oil Producers, Inc.
Shields Building
Russell, Kansas 67665

Sec. 9 Twp. 9 Rng. 30

Farm Schlitz No. 1-A

Location C NW NE

Total Depth 4280'

County Sheridan

Comm. 5-16-70 Comp. 5-23-70

Elevation: 2955' K. B.

Contractor L. J. Dreiling & Sons, Inc.
Victoria, Kansas 67671

2952' D. F.

2950' G. R.

Casing Record

Cement Record

Production: D & A

294' -8 5/8" - Surface Pipe 210 sacks cement

Figures Indicate Bottom of Formations

0'	201'	Surface soil & sand
201'	230'	Sand
230'	255'	Orangeburg
255'	310'	Shale
310'	1295'	Shale
1295'	2085'	Shale & Sand
2085'	2255'	Shale
2255'	2360'	Sand - Shale
2360'	2562'	Shale
2562'	2599'	Anhy.
2599'	2706'	Shale - Shell
2706'	2890'	Shale with Lime Stks.
2890'	3210'	Shale & Lime
3210'	3375'	Shale - Lime
3375'	3540'	Lime & Shale
3540'	3642'	Lime & Shale
3642'	3800'	Lime
3800'	3950'	Lime
3950'	4016'	Lime & Shale
4016'	4048'	Lime
4048'	4142'	Lime
4142'	4177'	Lime & Shale
4177'	4222'	Lime
4222'	4280'	Lime
4280'	T.D.	

STATE OF KANSAS)
)ss
COUNTY OF ELLIS)

I, Leo F. Dreiling, of the L. J. Dreiling & Sons, Inc., upon oath states that the above and foregoing is a true and correct copy from the Daily Drilling Report from your Schlitz #1-A.

Leo F. Dreiling
LEO F. DREILING

Subscribed and sworn to before me this 25th day of May, 1970.

Joseph A. Hess
JOSEPH A. HESS - NOTARY PUBLIC

My commission expires: September 19, 1970.

RECEIVED
STATE CORPORATION COMMISSION
MAY 26 1970
CONSERVATION DIVISION
Wichita, Kansas
05-26-1970

