


WELL PLUGGING RECORD

Give All Information Completely  
Make Required Affidavit  
Mail or Deliver Report to:  
Conservation Division  
State Corporation Commission  
211 No. Broadway  
Wichita, Kansas

NORTH

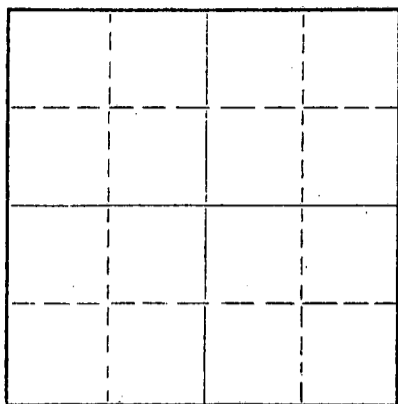

Locate well correctly on above  
Section Plat

SHERIDAN County. Sec. 28 Twp. 9 Rge. (E) 30 (W)  
Location as "NE/CNW&SW&" or footage from lines SE SE NE  
Lease Owner EMPIRE DRILLING COMPANY  
Lease Name MOELLERING Well No. 1  
Office Address 650 FOURTH NATIONAL BANK BUILDING  
Character of Well (completed as Oil, Gas or Dry Hole) DRY HOLE  
Date well completed AUGUST 13, 1958 19  
Application for plugging filed AUGUST 13, 1958 19  
Application for plugging approved AUGUST 13, 1958 19  
Plugging commenced AUGUST 13, 1958 19  
Plugging completed AUGUST 13, 1958 19  
Reason for abandonment of well or producing formation DRY HOLE

If a producing well is abandoned, date of last production 19  
Was permission obtained from the Conservation Division or its agents before plugging was commenced? YES

Name of Conservation Agent who supervised plugging of this well A. D. FABRICIUS  
Producing formation \_\_\_\_\_ Depth to top \_\_\_\_\_ Bottom \_\_\_\_\_ Total Depth of Well 4575 Feet  
Show depth and thickness of all water, oil and gas formations.

OIL, GAS OR WATER RECORDS

CASING RECORD

FORMATION	CONTENT	FROM	TO	SIZE	PUT IN	PULLED OUT
	SURFACE	0	176	8 5/8"	176	0

Describe in detail the manner in which the well was plugged, indicating where the mud fluid was placed and the method or methods used in introducing it into the hole. If cement or other plugs were used, state the character of same and depth placed, from \_\_\_\_\_ feet to \_\_\_\_\_ feet for each plug set.

PLUG SET @ 600' WITH 25 SACKS CEMENT  
PLUG SET @ 170' WITH 15 SACKS CEMENT  
PLUG SET @ 40' WITH 10 SACKS CEMENT

(If additional description is necessary, use BACK of this sheet)

Name of Plugging Contractor EMPIRE DRILLING COMPANY  
Address 650 FOURTH NATIONAL BANK BUILDING WICHITA, KANSAS

STATE OF KANSAS, COUNTY OF SEDGWICK, ss.  
I, DAN J. KORNFELD (owner or operator) of the above-described well, being first duly sworn on oath, says: That I have knowledge of the facts, statements, and matters herein contained and the log of the above-described well as filed and that the same are true and correct. So help me God.

(Signature) *Dan J. Kornfeld*  
650 FOURTH NATIONAL BANK BUILDING (Address)

SUBSCRIBED AND SWORN TO before me this 19TH day of AUGUST, 19 58  
My commission expires OCTOBER 21, 1958



*Lucille Jaro*  
Notary Public.

PLUGGING  
FILE SEC 20 T 9 R 30W  
BOOK PAGE 123 LINE 31

RECEIVED  
STATE CORPORATION COMMISSION  
AUG 20 1958  
08-20-1958  
CONSERVATION DIVISION  
Wichita, Kansas

15-179-00076-00-00

LOG

COMPANY: EMPIRE DRILLING COMPANY AND N. C. R. A., WICHITA, KANSAS

CONTRACTOR: EMPIRE DRILLING COMPANY, WICHITA, KANSAS

FARM: MOELLERING NUMBER 1

LOCATION: SE SE NE SECTION 28-9-30W, SHERIDAN COUNTY, KANSAS

COMMENCED: JULY 31, 1958

ELEVATION: 2896 KB

COMPLETED: AUGUST 13, 1958

POTENTIAL:

0	TO	194	SAND AND SHALE
194	TO	1480	SHALE AND SHELLS
1480	TO	1930	SHALE, LIME AND SHELLS
1930	TO	2485	SHALE AND SHELLS
2485	TO	2515	ANHYDRITE
2515	TO	2983	SHALE AND SHELL
2983	TO	3300	SHALE AND LIME
3300	TO	3324	LIME AND SHALE
3324	TO	3375	SHALE AND LIME
3375	TO	3935	LIME AND SHALE
3935	TO	4280	LIME
4280	TO	4325	SHALE
4325	TO	4370	LIME AND SHALE
4370	TO	4406	SHALE
4406	TO	4505	SHALE AND LIME
4505	TO	4550	SHALE
4550	TO	4575	SHALE, LIME, CHERT
		4575	RTD
			D & A

SET: 8 5/8" 176' WITH 115 SACKS CEMENT

TOPS:	HEEBNER	3925
	TORONTO	3947
	LANSING KANSAS CITY	3966
	BASE KANSAS CITY	4228
	CHEROKEE	4380
	MISSISSIPPIAN	4523

CERTIFICATION

I, DAN J. KORNFELD, DO HEREBY CERTIFY THAT THE ABOVE AND FOREGOING IS A TRUE AND CORRECT COPY OF THE LOG ON THE MOELLERING NUMBER 1, SE SE NE SECTION 28-9-30W, SHERIDAN COUNTY, KANSAS, AS REFLECTED BY THE FILES OF THE EMPIRE DRILLING COMPANY.

*Dan J. Kornfeld*  
DAN J. KORNFELD

SUBSCRIBED AND SWORN TO BEFORE ME, A NOTARY PUBLIC WITHIN AND FOR SEDGWICK COUNTY, KANSAS, THIS 19TH DAY OF AUGUST, 1958.

*Lucille Harr*  
LUCILLE HARR, NOTARY PUBLIC

MY COMMISSION EXPIRES OCTOBER 21, 1958



RECEIVED  
OCTOBER 21, 1958  
CONSOLIDATION DIVISION  
Wichita, Kansas

PLUGGING  
FILE SEC. 28 T. 9 R. 30W  
BOOK PAGE 123 LINE 31