


Give All Information Completely
Make Required Affidavit
Mail or Deliver Report to:
Conservation Division
State Corporation Commission
212 No. Market
Wichita, Kansas

WELL PLUGGING RECORD

Sheridan County, Sec. 32 Twp. 9 Rge. (E)30 (W)
Location as "NE/CNW/SW" or footage from lines SW NW
Lease Owner NATIONAL ASSOCIATED PETROLEUM CO.
Lease Name GEORGE BOEGER COMMUNITY Well No. 1
Office Address Petroleum building Tulsa, Oklahoma
Character of Well (completed as Oil, Gas or Dry Hole) Dry Hole
Date well completed April 29 19 69
Application for plugging filed April 29 19 69
Application for plugging approved April 29 19 69
Plugging commenced April 29 19 69
Plugging completed April 29 19 69
Reason for abandonment of well or producing formation _____

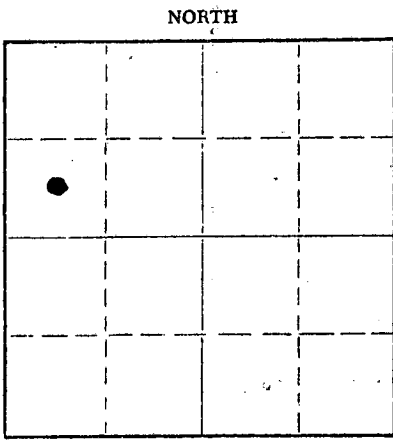

Locate well correctly on above Section Plat

If a producing well is abandoned, date of last production _____ 19____
Was permission obtained from the Conservation Division or its agents before plugging was commenced? yes

Name of Conservation Agent who supervised plugging of this well W. L. Nichols
Producing formation _____ Depth to top _____ Bottom _____ Total Depth of Well 4945 Feet
Show depth and thickness of all water, oil and gas formations.

OIL, GAS OR WATER RECORDS

CASING RECORD

FORMATION	CONTENT	FROM	TO	SIZE	PUT IN	PULLED OUT
				8 5/8"	267'	-0-

Describe in detail the manner in which the well was plugged, indicating where the mud fluid was placed and the method or methods used in introducing it into the hole. If cement or other plugs were used, state the character of same and depth placed, from _____ feet to _____ feet for each plug set.

Mud to 1525'
Cement 80 sacks
Mud to 275'
Cement 15 sacks
Mud to 40'
Cement 5 sacks

RECEIVED
STATE CORPORATION COMMISSION
MAY 12 1969
CONSERVATION DIVISION
Wichita, Kansas
0512-1969

(If additional description is necessary, use BACK of this sheet)

Name of Plugging Contractor Globe Oil Well Cementing
Address Great Bend, Kansas

STATE OF Oklahoma, COUNTY OF Tulsa, ss.
Jack Roberts (employee of owner) or (owner or operator) of the above-described well, being first duly sworn on oath, says: That I have knowledge of the facts, statements, and matters herein contained and the log of the above-described well as filed and that the same are true and correct. So help me God.

(Signature) Jack Roberts
NATIONAL ASSOCIATED PETROLEUM COMPANY
PETROLEUM BLDG. TULSA, OKLAHOMA
(Address)

SUBSCRIBED AND SWORN TO before me this 29th day of April, 1969

My commission expires Dec 15, 1972
Sam L. Marsh Notary Public.



15-179-20201-00-00



Broken Arrow Drilling Company

ROOM 409 PETROLEUM BUILDING • TULSA, OKLAHOMA 74103 • AC 918-582-1181

DRILLER'S LOG

COMPANY: NATIONAL ASSOCIATED PETROLEUM
 Petroleum Building
 Tulsa, Oklahoma 74103

FARM: George Boeger Comm. NO. 1

TOTAL DEPTH 4945'

COM.: 4/9/69 **COMP.:** 4/29/69

CONTRACTOR: BROKEN ARROW DRILLING CO.

SEC. 32 **TWP.** 9S **RGE.** 30W

LOCATION: SW-NW

COUNTY: Sheridan

ELEVATION 2979

PRODUCTION: D & A

CASING RECORD: 267' New 8-5/8"


CEMENT RECORD: 150 sacks cement
 100#A.C. - 200#C.C.

0' - 220'	Sandy Soil
220' - 1990'	Shale
1990' - 2550'	Sand & Shale
2550' - 2580'	Anhydrite
2580' - 3495'	Lime & Shale
3495' - 4365'	Lime
4365' - 4567'	Lime & Shale
4567' - 4794'	Lime
4794' - 4800'	Shale
4800' - 4945'	Lime & Chert
T.D. 4945'	

We hereby certify that the above is a true copy of the Driller's Log for the above described well.

BROKEN ARROW DRILLING COMPANY
By:

Jack Roberts
Jack Roberts

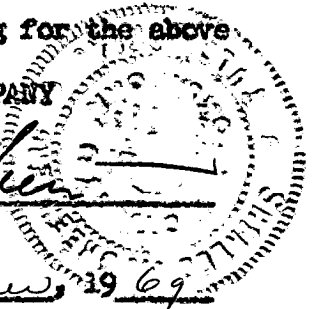

Subscribed and sworn to before me this 26th day of September, 19 69

My Commission expires:
April 14, 1973

Sheree M. Greenlee
Notary Public