

WELL PLUGGING RECORD


STATE CORPORATION COMMISSION

Give All Information Completely
Make Required Affidavit
Mail or Deliver Report to:
Conservation Division
State Corporation Commission
211 No. Broadway
Wichita, Kansas

Thomas County, Sec. 1 Twp. 9S Rge. 33S (E) (W)

Location as "NE/CNW/SW" or footage from lines C/NW NW
Lease Owner Doloco Exploration Trust - Murfin Drilling Company
Lease Name B. LEAK Well No. One
Office Address 617 Union Center Bldg. - Wichita 2, Kansas
Character of Well (completed as Oil, Gas or Dry Hole) Dry Hole
Date well completed 7/22/63 19
Application for plugging filed 7/23/63 19
Application for plugging approved 7/23/63 19
Plugging commenced 7/23/63 19
Plugging completed 7/23/63 19
Reason for abandonment of well or producing formation

NORTH

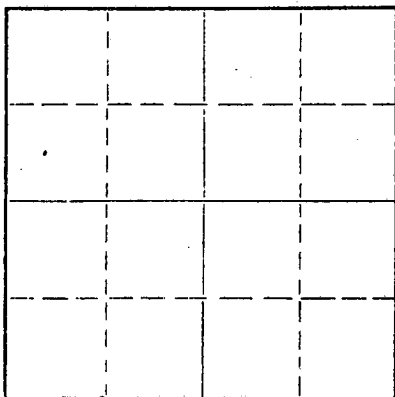

Locate well correctly on above Section Plat

If a producing well is abandoned, date of last production 19
Was permission obtained from the Conservation Division or its agents before plugging was commenced? Yes

Name of Conservation Agent who supervised plugging of this well W. L. Nichols - Morland, Kansas
Producing formation Depth to top Bottom Total Depth of Well 4769 Feet
Show depth and thickness of all water, oil and gas formations.

OIL, GAS OR WATER RECORDS

CASING RECORD

Table with 7 columns: FORMATION, CONTENT, FROM, TO, SIZE, PUT IN, PULLED OUT. Row 1: SIZE 8 5/8", PUT IN 280', PULLED OUT None.

Describe in detail the manner in which the well was plugged, indicating where the mud fluid was placed and the method or methods used in introducing it into the hole. If cement or other plugs were used, state the character of same and depth placed, from feet to feet for each plug set.

Set first plug @ 600' with 30 sacks cement. Set second plug @ 350' with 30 sacks cement.

RECEIVED STATE CORPORATION COMMISSION

AUG 19 1963

08-19-1963

CONSERVATION DIVISION Wichita, Kansas

(If additional description is necessary, use BACK of this sheet)

Name of Plugging Contractor Murfin Drilling Company
Address 617 Union Center Building - Wichita 2, Kansas

STATE OF Kansas COUNTY OF Sedgwick, ss.

I, Fred Murfin - Partner

(Signature of owner) of the above-described well, being first duly sworn on oath, says: That I have knowledge of the facts, statements, and matters herein contained and the log of the above-described well as filed and that the same are true and correct. So help me God.

(Signature)

617 Union Center Bldg. - Wichita 2, Kansas

(Address)

Subscribed and sworn to before me this 16th day of August, 1963

Mary Louise Blume

Notary Public.



WELL LOG

193-30025-00-00
~~15-165~~

COMPANY Doloco Exploration Trust - Murfin Drig. Co. SEC. 1 T. 9S R. 33S

FARM B. LEAK NO. One

LOC. G/NW NW


RIG. NO. 2

TOTAL DEPTH 4769'

COUNTRY Thomas KANSAS

COMM. See Below COMP. See Below

SHOT OR TREATED No
CONTRACTOR Murfin Drilling Company

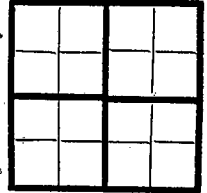

CASING

20 10 1st Hole 8 5/8" 267' with 235 sacks cement
15 8 2nd Hole 8 5/8" 280' with 250 sacks cement
12 ELEVATION 3123' Ground
13 5 PRODUCTION D * A

FIGURES INDICATE BOTTOM OF FORMATIONS

FIRST HOLE Comm. 6/30/63 Comp. 7/7/63

- 80' Shale
- 225' Sand
- 1750' Shale
- 2160' Shale and Sand
- 2355' Shale-Lime, Hard Sand
- 2465' Sand-Shale
- 2719' Red Bed
- 2749' Anhydrite
- 2981' Shale and Sand
- 3100' Shale
- 3225' Shale-Lime
- 3400' Shale
- 3595' Lime-Shale
- 3655' Shale and Lime
- 4080' Lime-Shale
- 4282' Lime

Lost hole at this point, did not skid rig, but we did drill a new hole right next to lost hole.

SECOND HOLE Comm. 7/13/63 Comp. 7/23/63

- 310' Cement
- 1910' Shale
- 2355' Shale-Sand
- 2383' Gyp
- 2725' Shale and Sand
- 2754' Anhydrite
- 2836' Shale and Sand
- 3425' Shale Lime
- 3528' Lime-Shale
- 3695' Shale-Lime
- 3770' Lime
- 4060' Shale-Lime
- 4769' Lime
- 4769' Rotary Total Depth

NO DST

NO LOG

RECEIVED
STATE CORPORATION COMMISSION

AUG 19 1963
08-19-1963
CONSERVATION DIVISION
Wichita, Kansas

State of Kansas
County of Sedgwick } ss:

I, Fred Murfin of the Murfin Drilling Company

upon oath state that the above and foregoing is a true and correct copy of the log of the B. LEAK #1 well.

Subscribed and sworn to before me this 16th day of August 19 63

My Commission Expires: June 14, 1964

Fred Murfin
Mary Louise Blume
NOTARY PUBLIC

