

15-193-30026-00-00

STATE OF KANSAS  
STATE CORPORATION COMMISSION

Form CP-4

Give All Information Completely  
Make Required Affidavit  
Mail or Deliver Report to:  
Conservation Division  
State Corporation Commission  
212 No. Market  
Wichita, Kansas

WELL PLUGGING RECORD

Thomas County, Sec. 5 Twp. 9S Rge. 33 (E) W (W)

Location as "NE/CNW/SW" or footage from lines. C SW SW SW

Lease Owner A. Ainsworth

Lease Name Chase Well No. 1

Office Address 4th National Bank Bldg., Wichita, Kansas

Character of Well (completed as Oil, Gas or Dry Hole) Dry

Date well completed 3/20 1966

Application for plugging filed 3/20 1966

Application for plugging approved 3/20 1966


Plugging commenced 3/21 1966

Plugging completed 3/21 1966

Reason for abandonment of well or producing formation

If a producing well is abandoned, date of last production 19

Was permission obtained from the Conservation Division or its agents before plugging was commenced? yes

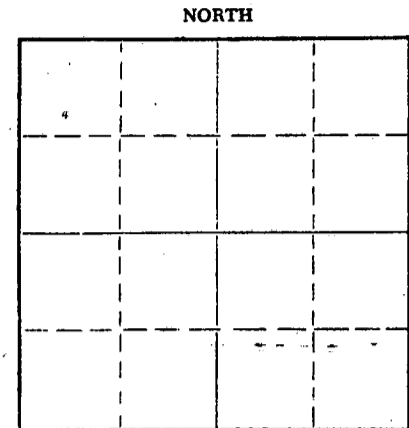

Locate well correctly on above Section Plat

Name of Conservation Agent who supervised plugging of this well W. L. Nichols

Producing formation Depth to top Bottom Total Depth of Well 4850 Feet

Show depth and thickness of all water, oil and gas formations.

OIL, GAS OR WATER RECORDS

CASING RECORD

FORMATION	CONTENT	FROM	TO	SIZE	PUT IN	PULLED OUT
				8 5/8	290'	-0-

Describe in detail the manner in which the well was plugged, indicating where the mud fluid was placed and the method or methods used in introducing it into the hole. If cement or other plugs were used, state the character of same and depth placed, from feet to feet for each plug set.

Filled hole with heavy mud to 600', set plug with 1/4 sack hulls on top of plug and 20 sacks cement through drill pipe.

Villed hole to 280'. Set plug with 1/4 sacks hulls on top and 20 sacks cement on top of plug through drill pipe.

Set plug at 40' and 10 sacks cement on top of plug.

RECEIVED  
STATE CORPORATION COMMISSION

MAR 25 1966  
03-23-1966  
CONSERVATION DIVISION  
WICHITA, KANSAS

(If additional description is necessary, use BACK of this sheet)

Name of Plugging Contractor  
Address

STATE OF Kansas COUNTY OF Barton, ss.

C. L. Miles, drlg. contractor (employee of owner) or (owner or operator) of the above-described well, being first duly sworn on oath, says: That I have knowledge of the facts, statements, and matters herein contained and the log of the above-described well as filed and that the same are true and correct. So help me God.

(Signature) C. L. Miles

P. O. Box 339, Great Bend, Kansas (Address)

22nd day of March, 1966



Keata L. Boyd Notary Public

15-193 - 30026-00-00

MILES DRILLING COMPANY  
P. O. BOX 339 GREAT BEND, KANSAS


WELL LOG  
Chase #1  
C/SW/SW/SW Sec. 5, Twp. 9S, Rge. 33W  
Thomas County  
Kansas

<u>FROM</u>	<u>TO</u>	
0	20	Shale
20	30	Sand
30	173	Shale-shalls
173	225	Sand
225	308	Shale-shalls
308	360	Mud
360	1010	Shale-shalls
1010	1555	Shale and sand
1555	1920	Shale, sand & shells
1920	1950	Shale
1950	1980	Sand
1980	2390	Shale and sand
2390	2450	Shale, lime sand mud
2450	2565	Shale-lime
2565	2742	Red bed
2742	2764	Anhydrite-lime
2764	2773	Anhydrite
2773	3540	Lime and shale
3540	3735	Lime
3735	3800	Shale
3800	3850	Lime
3850	4110	Lime and shale
4110	4428	Lime
4428	4480	Lime and shale
4480	4515	Lime-marmathon
4515	4540	Lime
4540	4590	Marmathon
4590	4703	Lime
4703	4817	Lime and chert
4817	4850	Miss.
4850	T.D.	Total depth

03-23-1964

STATE OF KANSAS  
COUNTY OF BARTON

C. L. Miles, dba Miles Drilling Company, being first duly sworn on oath says: that I have knowledge of the facts, statements and matters herein contained and the log of the above described well as filed and that the same are true and correct.

  
C. L. Miles

Reata L. Boyd, Notary Public  
Barton, County, Kansas

My commission expires 5/9/67