

15-193-20129-00-00

STATE OF KANSAS
STATE CORPORATION COMMISSION

WELL PLUGGING RECORD

Give All Information Completely
Make Required Affidavit
Mail or Deliver Report to
Conservation Division
State Corporation Comm.
245 North Water
Wichita, KS 67202

Thomas County. Sec. 22 Twp. 9S Rge. 33W E/W
Location as "NE/CNW $\frac{1}{4}$ /SW $\frac{1}{4}$ " or footage from lines


C SE SE. Sec
Lease Owner ISERN Petroleum Co.
Lease Name HERBAL "B" Well No. 1

Office Address Box 486, Ellinwood, Kansas 67526
Character of Well (Completed as Oil, Gas or Dry Hole)
Dry Hole

Date Well completed 4-15 1977
Application for plugging filed (Verbally) 4-15 1977
Application for plugging approved (Verbally) 4-15 1977
Plugging commenced 4-15 1977
Plugging completed 4-15 1977

Reason for abandonment of well or producing formation
No commercial quantity of oil or gas encountered
If a producing well is abandoned, date of last production 19

Was permission obtained from the Conservation Division or
its agents before plugging was commenced? Yes

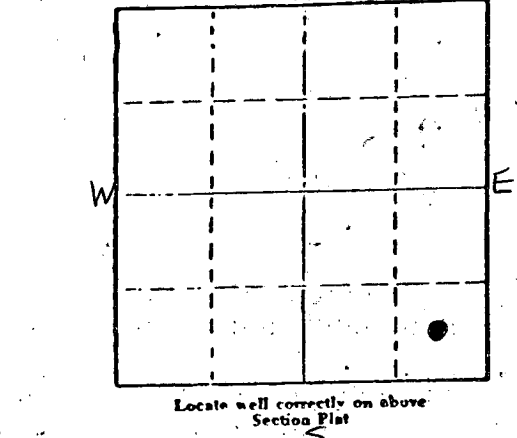

Name of Conservation Agent who supervised plugging of this well Leo Massey
Producing formation Depth to top Bottom Total Depth of Well
Show depth and thickness of all water, oil and gas formations.

OIL, GAS OR WATER RECORDS

CASING RECORD

FORMATION	CONTENT	FROM	TO	SIZE	PUT IN	PULLED OUT

Describe in detail the manner in which the well was plugged, indicating where the mud fluid was placed and the method or methods used in introducing it into the hold. If cement or other plugs were used, state the character of same and depth placed, from feet to feet for each plug set.

T.D. 4720', Set 1st plug at 2075' with 70 sx.,
2nd plug at 300' with 20 sx., 40' solid bridge
with 10 sx., 50/50 posmix, 6% gel.

Plug was down at 3:00 a.m. 4-15-77.
State Plugger - Leo Massey

RECEIVED
STATE CORPORATION COMMISSION
APR 21 1977
04-21-1977
CONSERVATION DIVISION
Wichita, Kansas

(If additional description is necessary, use BACK of this sheet)

Name of Plugging Contractor Abercrombie Drilling, Inc.

STATE OF Kansas COUNTY OF Sedgwick ss.
Jack L. Partridge, Asst. Sec.-Treas. (employee of owner) or (owner or operator) of the above-described well, being first duly sworn on oath, says: That I have knowledge of the facts, statements, and matters herein contained and the log of the above-described well as filed and that the same are true and correct. So help me God.

(Signature) Jack L. Partridge
801 Union Center, Wichita, Kansas 67202
(Address)

SUBSCRIBED AND SWORN TO before me this 18th day of April, 1977

My commission expires _____
Kathy S. Goertz
Kathy S. Goertz Notary Public.



15-193-20129-00-00

CONTRACTOR'S WELL LOG

OPERATOR:	ISERN Petroleum Co.
CONTRACTOR:	Abercrombie Drilling, Inc.
WELL NAME:	HERBAL "B" #1
LOCATION:	C SE SE, Section 22-9S-33W Thomas County, Kansas
SPUD DATE:	4-06-77
COMPLETION DATE:	4-15-77

0	128	Sand & Clay
128	2325	Sand & Shale
2325	2666	Shale & Red Bud
2666	2696	Anhydrite
2696	2920	Shale - Shells
2920	3965	Shale & Lime
3965	4275	Lime
4275	4325	Shale & Lime
4325	4720	Lime
	4720	Rotary Total Depth

Spud hole at 1:30 p.m. 4-06-77. Cut 335' of 12 1/4" hole. Ran 8 jts. of used 28# - 8 5/8" surface casing. (Tally 321.62') Set at 329.62'. Cemented with 225 Sx. of common cement, 2% gel, 3% Ca. Cl. Cement by Sun. Plug was down at 9:00 p.m. 4-06-77. Cement did circulate.

T.D. 4720', Set 1st plug at 2075' with 70 sx., 2nd plug at 300' with 20 sx., 40' solid bridge with 10 sx., 50/50 posmix, 6% gel. Plug was down at 3:00 a.m. 4-15-77. State Plugger - Leo Massey.

SAMPLE TOPS:

Anhydrite 2666'
B/Anhydrite 2696'

RECEIVED
STATE CORPORATION COMMISSION

APR 21 1977

04-21-1977
CONSERVATION DIVISION
Wichita, Kansas


STATE OF KANSAS)
) SS
COUNTY OF SEDGWICK)

Jack L. Partridge, Assistant Secretary-Treasurer of Abercrombie Drilling, Inc. does hereby state that the above and foregoing is a true and correct copy of the log of the HERBAL "B" #1, C SE SE, Section 22-9S-33W, Thomas County, Kansas.

ABERCROMBIE DRILLING, INC.

BY: Jack L. Partridge
Jack L. Partridge, Asst. Sec.-Treas.

Subscribed and sworn to before me, a Notary Public, in and for the aforesaid county and state as of this 18th day of April, 1977.

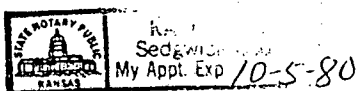

Kathy S. Goertz
Kathy S. Goertz, Notary Public