


Give All Information Completely
Make Required Affidavit
Mail or Deliver Report to:
Conservation Division
State Corporation Commission
212 No. Market
Wichita, Kansas

WELL PLUGGING RECORD

NORTH

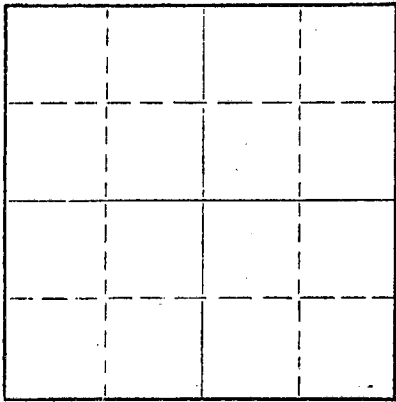

Locate well correctly on above
Section Plat

Thomas County, Sec. 25 Twp. 9S Rge. ~~XX~~ 33 (W)
Location as "NE/CNW/SW" or footage from lines C NE SW
Lease Owner Pickrell Drilling Company
Lease Name Ross "A" Well No. 1
Office Address 705 Fourth National Bank Bldg., Wichita, Kansas
Character of Well (completed as Oil, Gas or Dry Hole) Dry Hole
Date well completed March 6 19 70
Application for plugging filed March 6 19 70
Application for plugging approved March 6 19 70
Plugging commenced March 6 19 70
Plugging completed March 6 19 70
Reason for abandonment of well or producing formation Dry Hole

If a producing well is abandoned, date of last production 19____
Was permission obtained from the Conservation Division or its agents before plugging was commenced? Yes

Name of Conservation Agent who supervised plugging of this well W. L. Nichols
Producing formation _____ Depth to top _____ Bottom _____ Total Depth of Well 4877 Feet
Show depth and thickness of all water, oil and gas formations.

OIL, GAS OR WATER RECORDS

CASING RECORD

FORMATION	CONTENT	FROM	TO	SIZE	PUT IN	PULLED OUT
				8-5/8"	333'	None

Describe in detail the manner in which the well was plugged, indicating where the mud fluid was placed and the method or methods used in introducing it into the hole. If cement or other plugs were used, state the character of same and depth placed, from _____ feet to _____ feet for each plug set.

Bottom Plug @ 1800' w/100 sacks cement, plug @ 360'
w/10 sacks, plug @ 40' with 10' sacks.


RECEIVED
STATE CORPORATION COMMISSION
MAR 16 1970
CONSERVATION DIVISION
Wichita, Kansas
03-16-1970

(If additional description is necessary, use BACK of this sheet)

Name of Plugging Contractor Pickrell Drilling Company
Address 705 Fourth National Bank Building, Wichita, Kansas 67202

STATE OF Kansas, COUNTY OF Sedgwick, ss.
C. W. Sebitts (employee of owner) or (owner or operator) of the above-described well, being first duly sworn on oath, says: That I have knowledge of the facts, statements, and matters herein contained and the log of the above-described well as filed and that the same are true and correct. So help me God.
(Signature) C. W. Sebitts
705 Fourth National Bank Bldg, Wichita, Kansas (Address)

SWORN TO before me this 12th day of March, 19 70
My commission expires January 19, 1973
Esther Lamone Notary Public.

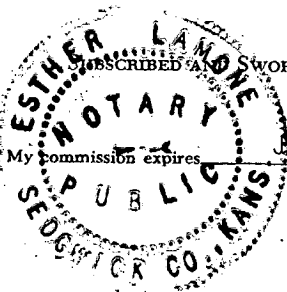

ROTARY DRILLING LOG

15493-20027-00-00

COMPANY: Pickrell Drilling Company
705 Fourth National Bank Building
Wichita, Kansas 67202

Rotary Drilling Commenced 2/19/70

Rotary Drilling Completed 3/6/70

LOCATION: Ross "A" No. 1, C NE SW Section 25-9S-33W,
Thomas County, Kansas

CONTRACTOR: PICKRELL DRILLING COMPANY
Wichita, Kansas

CASING RECORD: Run 17 Jts. 8-5/8" surface casing set @ 333' KB. Cemented with 220 sacks cement. Completed 11:15 P.M. Circulated.

No oil string run. D & A, Plugged 8:00 P.M. March 6, 1970.

LOG

(Figures indicate bottom of formation — measurements from top of rotary bushing.)

265	Sand & Sandy Clay	C.F.S.	
333	Shale	3900	4304
1840	Shale & Shells	3940	4325
2300	Shale	3980	4380
2330	Shale - Shells	4005	4420
2365	Blain	4035	4530
2440	Red Beds	4060	4542
2505	Sand	4101	4577
2691	Red Beds - Shale	4115	4595
2721	Anhydrite	4152	4630
3190	Shale & Lime	4167	4665
3285	Lime	4182	4680
3450	Lime & Shale & Sand	4197	4739
3733	Lime	4213	4755
4005	Lime & Shale	4235	4877
4705	Lime	4260	
4739	Mississippi Lime	4277	
4877	Lime, RTD		

RECEIVED
STATE CORPORATION COMMISSION
MAR 16 1970
CONSERVATION DIVISION
Wichita, Kansas
03-16-1970

	<u>S.L.M.</u>
Strap	3520.00
Board	3519.38
	.62 Difference

Slope Tests
2000
2500
3000
3500
4000
4500

The undersigned, C. W. Sebitts, Attorney-in-Fact for PICKRELL DRILLING COMPANY, hereby certifies in behalf of said Company, that the above is a true and correct log of the formation encountered in drilling the above well as reflected by the Daily Drilling Reports.

PICKRELL DRILLING COMPANY
By [Signature]
C. W. Sebitts Attorney-in-Fact

STATE OF KANSAS
COUNTY OF SEDGWICK } ss.:

12th day of March, 1970, before me the undersigned, a Notary Public, in and for

County of Sedgwick, personally appeared C. W. Sebitts, to me known to be the person who subscribed the name of PICKRELL DRILLING COMPANY to the foregoing instrument, as its authorized agent, and he acknowledged to me that he executed the same as his free and voluntary act and deed, and that he is duly authorized to execute the same on behalf of such company, for the uses and purposes therein set forth.

I have given my hand and seal of office the day and year last above written.



Jan. 19, 1973

Esther Lamone
Esther Lamone Notary Public